

Cowley


KANSAS

SECTION 22 TOWNSHIP 32 RANGE 4E

WELL NO. #11 Dibbens

COMPANY Beaumont Petr.

NORTH C N/2 NE

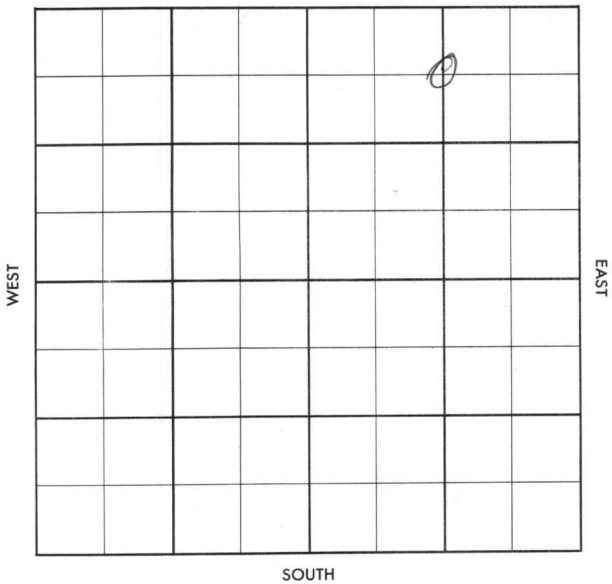

County Cowley Elev. _____
 Sec. 22 Twp. 32 Rge. 4E
 Company Beaumont Pet.
 Farm Name Dibbens No. 11

TOPS	DEPTH	LOG	DATUM
Anh.			
Tp.			
H.			
Tr.			
Dg.			
Bl.			
L.			
K.C.			
B.K.C.			
Ce.			
C.			
M.			
M.			
K.			
Mz.			
Me.			
V.			
S.			
S.			
A.			
R.			
Pe.			
G.			
T.D.			

Loc. in Sec. C N/2 NE
Arb. test
 Geol. _____
 Contr. _____
Co. Tools
 Pool _____

FIRST REPORT
 APR 3 '57

Date Comm. MIST

29

Co. Lse. No. Sec. T. R.

MacCollins

County Cowley Elev. 1206 Co.
 Sec. 22 Twp. 32 Rge. 4E
 Company Beaumont Pet.
 Farm Name Dibbens No. 11

TOPS	DEPTH	LOG	DATUM
Anh.			
Tp.			
H.			
Tr. <u>L84</u>	<u>2205</u>		
Dg.			
Bl.			
L.			
K.C.	<u>2475</u>		
B.K.C.	<u>2595</u>		
Ce. <u>Marm</u>	<u>2655</u>		
C. <u>CB</u>	<u>2770</u>		
M. <u>Bartl.</u>	<u>2920</u>		
M.	<u>2970</u>		
K.	<u>3195</u>		
Mz.			
Me.			
V.			
S.			
S.			
A.	<u>3257</u>	<u>3251</u>	
R.			
PE.			
G.			
TD.	<u>3340</u>		

Loc. in Sec. C N/2 NE
Arb. test
 Geol. _____
 Contr. _____
 Co. Tools _____
 Pool state _____



Date Comm. MIST APR 10 '57 APR 17 '57 4-11-57
8 5/8 105/75 10 2160 APR 24 '57
5 1/2 @ 3340 MAY 1 '57 CO MAY 8 '57 CO
3321 12/3252-53 1/4 MAY 15 '57
POP MAY 22 '57 ✓ MAY 29 '57 SPORC JUN 5 '57
 JUN 12 '57 JUN 19 '57 JUN 26 '57 JUL 3 '57 JUL 10 '57 JUL 17 '57
 JUL 24 '57 JUL 31 '57 AUG 8 '57 X Pump trouble
make Maximum 30 Bopd + 20 Dwpd
comp 25 Bopd ⁺²⁰ Arb PF. 3252-53
RTD 3340

Co.
 Lse.
 No.
 Sec.
 T.
 R