

Cawley

Map No. KANSAS Sec. 22 Twp. 32 R. 4E

Well No. 1- Fee Farm

North & Fowrat Company


_____ Ft. from N. Line

560 Ft. from S. Line

_____ Ft. from E. Line

450 Ft. from W. Line

1932 Lot 11- Blk 14

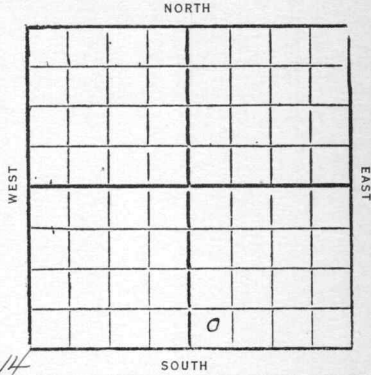

Date

REPORT

| | |
|-------------|---------------------------|
| <u>3/9</u> | <u>Rob.</u> |
| <u>3/16</u> | <u>Bldg req</u> |
| <u>3/22</u> | <u>Run up</u> |
| <u>3/30</u> | <u>_____</u> |
| <u>4/6</u> | <u>15"-428</u> |
| | <u>dreg 480</u> |
| <u>4/13</u> | <u>12"-1000</u> |
| | <u>Dreg 1090</u> |
| <u>4/20</u> | <u>" 1583</u> |
| <u>4/27</u> | <u>Run 10"-1760'</u> |
| <u>5/4</u> | <u>Dreg 2065</u> |
| <u>5/11</u> | <u>Land 2380-2405</u> |
| | <u>swab 85 bbl 24 hrs</u> |
| <u>5/18</u> | <u>Land 2380-2405</u> |
| | <u>T.D 2405</u> |
| | <u>Pump 100 bbl oil</u> |
| | <u>Cor'p.</u> |

Cowley

E

2 KANSAS Map No. Sec. 22 Twp. 32 R. 4

Well No. 1 Fee

Roch & Jaurat Company

Contractor

FIRST REPORTS

SECTION PLAT

Ft. from N. Line

500 Ft. from S. Line

Ft. from E. Line

450 Ft. from W. Line

| | | | |
|--|--|---|--|
| | | | |
| | | | |
| | | | |
| | | 0 | |

50T 11- Blk 14

Location

Rig up

Drilling and Remarks:

R.O.S.

RECORD

Cased in., ft.

Sand

Gas

Oil

Total Depth

PRODUCTION

1st 24 hrs. Nat.

1st 24 hrs. after shot

Gas Cu. Ft.

Dry Hole

Abandoned

Date

MAR 9 1932 CHAS. L. SHERWOOD

Cowley

E

2 KANSAS Map No. Sec. 22 Twp. 32 R. 14

Well No. 1 Fee
Krebs & Jaurig Company

Contractor

COMPLETED

SECTION PLAT

Ft. from N. Line
560 Ft. from S. Line
Ft. from E. Line
450 Ft. from W. Line

| | | | |
|--|--|--|--|
| | | | |
| | | | |
| | | | |
| | | | |
| | | | |

Location

Rig up

Drilling and Remarks:

Pump 100 Bls.

RECORD

Cased in, ft.
Sand 2380-2405
Gas
Oil
Total Depth 2405

PRODUCTION

1st 24 hrs. Nat.
1st 24 hrs. after shot
Gas Cu. Ft.
Dry Hole
Abandoned

Date

MAY 1 8 1932 CHAS. L. SHERWOOD 192 Scout