
Form 51—5M—10-26—Mid-West

KANSAS

Map No. ..... Sec. 3 Twp. 27 R. 6

Well No. 5 - Lewis Farm

Davis & Hazlett Company

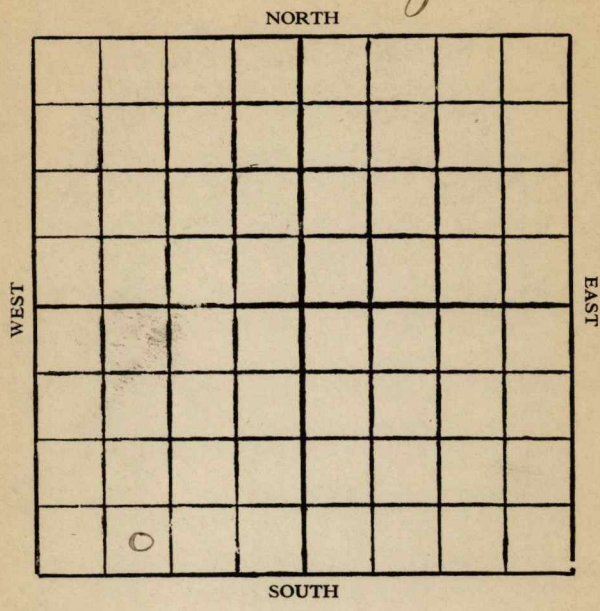


Location	Rig Up
Drilling Remarks	Drilling Remarks
RECORD	PRODUCTION
Cased ..... in. ..... ft.	1st 24 hrs. Nat.
Sand	1st 24 hrs. after shot
Gas	Gas ..... cu. ft.
Oil	Dry Hole
Total Depth	Abandoned

Form 252A—5M—4-27—27425

Map No. KANSAS Sec. 3 Twp. 27 R. 6

Well No. 5—Lewis Farm

Davis & Hazlett Company

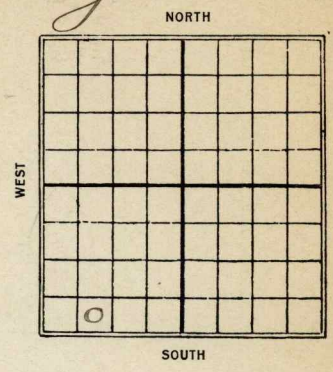

_____ Ft. from N. Line

330 Ft. from S. Line

_____ Ft. from E. Line

990 Ft. from W. Line

1928

Date	REPORT
3/8	R. O. G.
3/16	Rig
3/22	Rigging up—
3/29	Drilling 600
4/5	" 1310
4/12	" 2150
4/19	Top lime 2738 - Showoil - drilling 2795 -
4/26	Base lime 3060 - Ad 3130-46 T. D. 3148 - in green shale — 1200' oil in hole —
5/3	3130-3146 T. D. 3148 Top lime 2738-3060 120 bbls

Form 26—1M Bks.—3-23—11959.

Butler

Map No. 11 KANSAS Sec. 3 Lewis Twp. 27 R. 6

Well No. 5

Davis & Hazlett Company

Contractor

FIRST REPORTS


330 Ft. from N. Line

Ft. from S. Line

Ft. from E. Line

990 Ft. from W. Line

SECTION PLAT

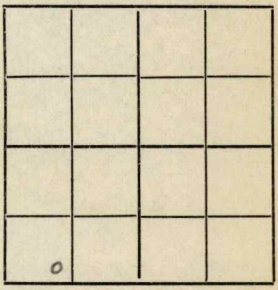

Location

Rig up

Drilling and Remarks:

R.O.G

RECORD

Cased in., ft.

Sand

Gas

Oil

Total Depth

PRODUCTION

1st 24 hrs. Nat.

1st 24 hrs. after shot

Gas Cu. Ft.

Dry Hole

Abandoned

Date

MAR 8 1928

192

CHAS. L. SHERWOOD

Scout

Form 26—1M Bks.—3-23—11959. Butler

11 KANSAS

Map No.---------- Sec. 3 Twp. 27 R. 6


Well No. 5 Lewis

Davis & Hazlett Company

Contractor

COMPLETED

SECTION PLAT

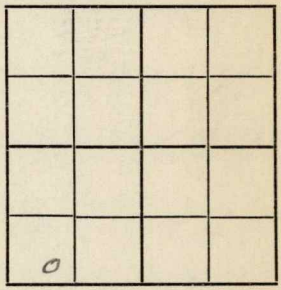

---Ft. from N. Line

330 Ft. from S. Line

---Ft. from E. Line

990 Ft. from W. Line

Location ----------

Rig up ----------

Drilling and Remarks:

TL 2738-3060'

170 Bbls.

RECORD

Cased ------ in., ------ ft.

Sand 3130-3146

Gas ----------

Oil ----------

Total Depth 3148

PRODUCTION

1st 24 hrs. Nat. ----------

1st 24 hrs. after shot ------

Gas ---------- Cu. Ft.

Dry Hole ----------

Abandoned ----------

Date

MAY 3 1928 CHAS. L. SHERWOOD

----------192---- ----------Scout