


Cowley

Form 51-5M-2-29-34703

Map No. KANSAS Sec. 22 Twp. 32 R. 4^E

Well No. L. J. W. Robbins Farm
Pravie O & S Company

NORTH

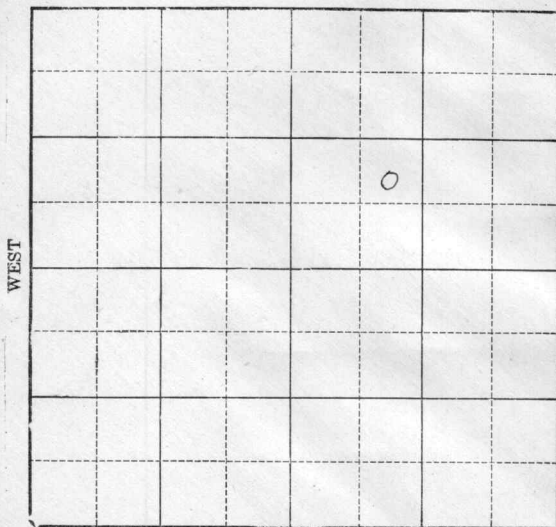

SOUTH

Blk 12 - College View Add

Location _____

Drilling Remarks _____

Rig Up _____

Drilling Remarks _____

RECORD

Cased _____ in. _____ ft.

Sand _____

Gas _____

Oil _____

Total Depth _____

PRODUCTION

1st 24 hrs. Nat. _____

1st 24 hrs. after shot _____


Gas _____ cu. ft.

Dry Hole _____

Abandoned _____

Cowley
 Map No. KANSAS Sec. 22 Twp. 32 R. 4E
 Well No. J. W. Robbins Farm
Prarie O & G Company

NORTH

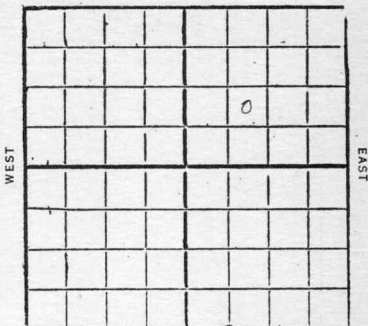

_____ Ft. from N. Line

884 Ft. from S. Line

_____ Ft. from E. Line

940 Ft. from W. Line

1932 Bek 12- Colleg View Add

Date	REPORT
2/3	Bldg reg
2/10	Bldg
2/17	Dreg 435'
2/26	" 1094'
3/2	Setg 10"-1710'
3/9	14FW 1950-60 Dreg 2215'
3/16	TD 2305' Fishing
3/22	
3/30	8"-2313
	show oil 2354-62
	dreg 2380'
4/6	Had 3/4 M gas 2895
	dreg 2940'
4/13	Cased 5"-3252
	Silic line 3251-62
	TD 3262
	(Oil from 3251-54)
	Increase 3260-62
	swab 706 t.bl oil
	Comp.

Cawley

E

Map No. _____ Sec. 22 Twp. 32 R. 4

Well No. 2 J. W. Dibbins

Prairie Oil & Gas Co Company

Contractor

FIRST REPORTS

SECTION PLAT

_____ Ft. from N. Line

884 Ft. from S. Line

_____ Ft. from E. Line

940 Ft. from W. Line

		o	

Blk 12, College View addn

Location _____

Rig up _____

Drilling and Remarks:

Blag Rig

RECORD

Cased _____ in., _____ ft.

Sand _____

Gas _____

Oil _____

Total Depth _____

PRODUCTION

1st 24 hrs. Nat. _____

1st 24 hrs. after shot _____

Gas _____ Cu. Ft.

Dry Hole _____

Abandoned _____

Date

FEB 3 1932

CHAS. L. SHERWOOD

19

Scout

Cowley

2 KANSAS

Map No. Sec. 22 Twp. 32 R. 4 E

Well No. 2 J. W. Debus

Prairie Oil & Gas Co Company Contractor

COMPLETED

SECTION PLAT

		0	

Ft. from N. Line

884 Ft. from S. Line

Ft. from E. Line

940 Ft. from W. Line

Location

Rig up

Drilling and Remarks:

Oil 3751-54
Increase 3760-62
About 706 lbs

RECORD

Cased 5" in., 3752 ft.

Sand Siliceous 3751-62

Gas

Oil

Total Depth 3762

PRODUCTION

1st 24 hrs. Nat.

1st 24 hrs. after shot

Gas Cu. Ft.

Dry Hole

Abandoned

Date

APR 13 1932

CHAS. L. SHERWOOD

192

Scout