

KANSAS


Cowley

Map No. _____ Sec. *22* Twp. *32* R. *4* ^{*E*}

Well No. *2 J.W. Hibbens* Farm _____

Sunshine Prairie Company _____

NORTH

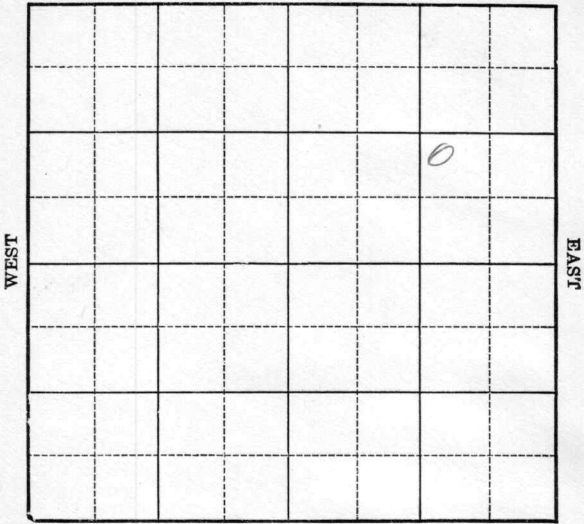

SOUTH

Lot 9 Blk. 4 Reynolds Addition

Location _____
Drilling Remarks _____

Rig Up _____
Drilling Remarks _____

RECORD

PRODUCTION

Cased _____ in. _____ ft.

Sand _____

Gas _____

Oil _____

Total Depth _____

1st 24 hrs. Nat. _____

1st 24 hrs. after shot _____

Gas _____ cu. ft.

Dry Hole _____

Abandoned _____

Cawley

KANSAS

Map No. _____ Sec. 22 Twp. 32 R. 4[≡]

Well No. 2 J W Hibbins Farm

Sinclair Prairie Company


_____ Ft. from N. Line

1080' Ft. from S. Line

_____ Ft. from E. Line

1450' Ft. from W. Line

Lot 9 Block 4
Reynolds Addn

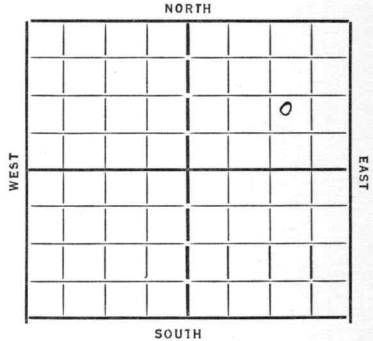

Date 7/33

REPORT

5/3 Spudding

5/10 Drly 925'

5/17 12" - 1142 Drly 1500'

5/24 10" 1728 Drly 2005

6/1 8" 2121 10" 2569 DP 2378-80
HFW 2475-80 SD 2569

6/14 Siliceous lime 3280

T.D. 3290

Swab 1200 bbls

COMPLETED

Crowley

E

Map No. KANSAS Sec. 22 Twp. 32 R. 4

Well No. 2 J. N. Dibbins

Sinclair Prairie Company

Contractor

FIRST REPORTS

SECTION PLAT

.....Ft. from N. Line

1080 Ft. from S. Line

.....Ft. from E. Line

1450 Ft. from W. Line

Lot 9 BIK 4

Reynolds addn

			o

Location.....

Rig up.....

Drilling and Remarks:

[Handwritten signature]

RECORD

Cased.....in.,ft.

Sand.....

Gas.....

Oil.....

Total Depth.....

PRODUCTION

1st 24 hrs. Nat.....

1st 24 hrs. after shot.....

Gas.....Cu. Ft.

Dry Hole.....

Abandoned.....

Date

MAY 3 1933

192

CHAS. L. SHERWOOD

Scout

Cowley

Map No. Sec. *22* Twp. *32* R. *4 E*

Well No. *2 - J. W. Robbins*

Sinclair-prairie Company
Contractor

Lot 9 Blk 4
Reynolds addn

SECTION PLAT

			0

.....Ft. from N. Line

1080 Ft. from S. Line

.....Ft. from E. Line

1450 Ft. from W. Line

COMPLETED

Location

Rig up

Drilling and Remarks:

Siliciouslime

3280

Swab 1200ft

RECORD

Cased in., ft.

Sand

Gas

Oil

Total Depth. *3290*

PRODUCTION

1st 24 hrs. Nat.

1st 24 hrs. after shot

Gas Cu. Ft.

Dry Hole

Abandoned

Date

4/14/33 192.....

Overman Scout