

Map No. KANSAS Sec. 22 Twp. 32 R. 4E

Well No. 2- Hill Farm

Goth & Howard Company


_____ Ft. from N. Line

545 Ft. from S. Line

_____ Ft. from E. Line

510 Ft. from W. Line

1932

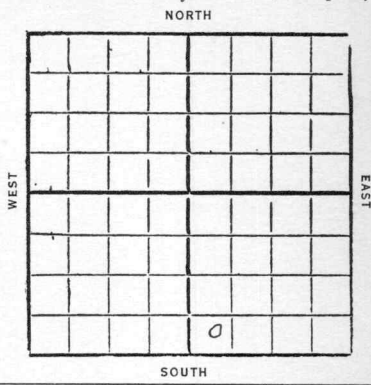

Date	REPORT <i>From well</i>
9/21	Bldg rig
9/30	Rig
10/5	Run up
10/12	Rig up 8510
10/19	
10/26	No report
11/2	15"-430
	Rig 12"-1010'
11/9	10"-1020
	dreg 1495
11/16	No report
11/23	10"-1622
	Dreg 2130'
11/30	2280'
12/7	show gas 2565
	HFV 2570-80
	Dreg 2600'
12/14	8"-2306
	SD 2775'
12/21	Dreg 2940'
12/28	Rig 6"-2960'
1933	
1/4	

1/11- SD 2960'

1/18- Sand 2965-97

TD 2997

Ray 2985-97

1/2 A gas

Comp.

Cowley

E

Map No. 2 KANSAS Sec. 22 Twp. 32 R. 4

Well No. 2 Fee

Proth & Farnat Company

Contractor

COMPLETED

SECTION PLAT

		0	

Ft. from N. Line

545 Ft. from S. Line

Ft. from E. Line

510 Ft. from W. Line

Log 10 Box 14

Location

Rig up

Drilling and Remarks:

Pay 2985-97

RECORD

Cased 2965-2997 in., ft.

Sand

Gas

Oil

Total Depth 2997

PRODUCTION

1st 24 hrs. Nat.

1st 24 hrs. after shot

Gas 1 1/2 Cu. Ft.

Dry Hole

Abandoned

Date

JAN 18 1933

CHAS. L. SHERWOOD

Scout