


Section 3 Township 27 Range 6E

Well No. #3 ~~#1~~ MacLean MacLean

Company Murfin Drlg.

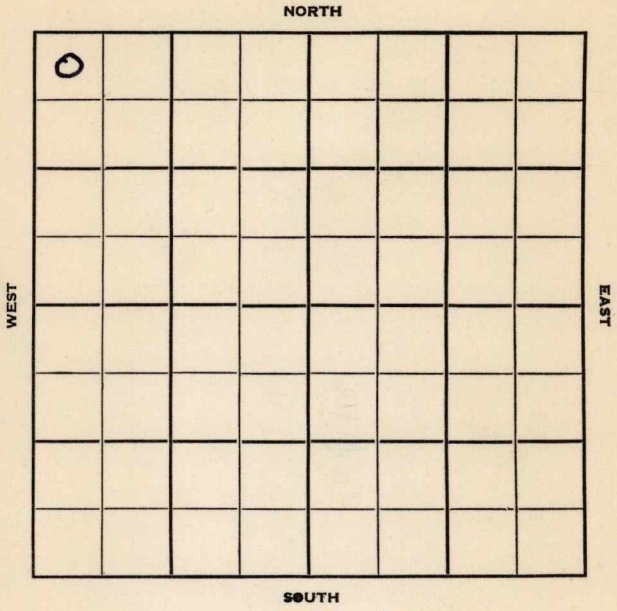

Butler

KANSAS ✓

Sec. 3 Twp. 27 R. 6E

Well No. ~~#1 MacLean "B"~~ #2 MacLean #3 MACLEAN Farm

Murfin Drlg.

Company

Murfin Drlg. - Contr.

Contractor


330' Ft. from N. Line

_____ Ft. from S. Line

_____ Ft. from E. Line

330' Ft. from W. Line

NW NW NW

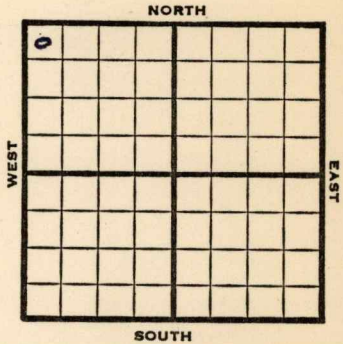

1952

Elev. 1419'

REPORT

7/9

MIM

9/17

Oil well TD 2810' 13" @ 525
 8" @ 1865 **KC 2122'** Miss 2783'
 7" @ 2786 TD 2810' 5" @ 2787
 12 GOPH PB 2790 CO to 2806
 1000 A 3/4 BO 3 BWPH
 Comp. 15 BOPD 20% wtr.

COMPLETED

County Butler State Kansas

Sec. 3 (Blk. 27 (Sur. 6E (Twp.) 6E Map No.

Operator Murfin Drlg.

Well No. 2 Farm MacLean

Elev. _____ Location NW NW NW

0					

330 Ft. From N Line NW

330 Ft. From W Line Quarter

Ist. Report JUL 9 1952

Completion _____

Remarks _____

Murfin Drlg. - Contr.

Spudding Date _____

Drlg. Data _____

M I M

County Butler State Kansas

Sec. 3 (Blk. Twp.) 27 (Sur. Rge.) 6E Map No.

Operator Murfin Drlg.

Well No. 3 Farm MacLean

Elev. 1419 Location NW NW NW

0				

COMPLETE

330 Ft. From N Line NW

330 Ft. From W Line Quarter

1st. Report

Completion SEP 17 1952

Remarks

Murfin Drlg. - Contr.

Spudding Date

Drlg. Data Oil well TD 2810

13" @ 525 8" @ 1865 KC 2122

Miss. 2783 7" @ 2786 TD 2810

5" @ 2787 12 goph PB 2790 CO to 2806

1000 A 3/4 bo 3 bwph

Comp. 15 bopd 20% wtr.

J. G. McGEHEE

Kansas

Map No. _____ Sec. 3 Twp. 27 R. 6E

Well No. 1 Maclean "B"

Murfin Drlg. _____ Company

_____ Contractor

NW NW NW

SECTION PLAT

330 Ft. from N. Line

_____ Ft. from S. Line

_____ Ft. from E. Line

330 Ft. from W. Line

0			

Butler County

Location _____

Rig up _____

Drilling and Remarks:

Reported
#2 Maclean

RECORD

Cased _____ in., _____ ft.

Sand _____

Gas _____

Oil _____

Total Depth _____

PRODUCTION

1st 24 hrs. Nat. _____

1st 24 hrs. after shot _____

Gas _____ Cu. Ft.

Dry Hole _____

Abandoned _____

Date

JUL 30 1952 19

J. G. McGEHEE

Scout

Butler Kansas

Map No. _____ Sec. 3 Twp. 27 R. 6E

Well No. 3 Maclean

Murfin Drlg. _____ Company

_____ Contractor

NW NW NW

SECTION PLAT

330 Ft. from N. Line

_____ Ft. from S. Line

_____ Ft. from E. Line

330 Ft. from W. Line

<u>0</u>			

CORRECTION

Location _____

Rig up _____

Drilling and Remarks:

Last reported

1 Maclean "B"

RECORD

Cased _____ in., _____ ft.

Sand _____

Gas _____

Oil _____

Total Depth _____

PRODUCTION

1st 24 hrs. Nat. _____

1st 24 hrs. after shot _____

Gas _____ Cu. Ft.

Dry Hole _____

Abandoned _____

Date

SEP 10 1952

J. G. McGEHEE

Scout