


Map No. KANSAS Sec. 22 Twp. 32 R. 4E

Well No. L. Sutton Farm
M. Nabb et al Company

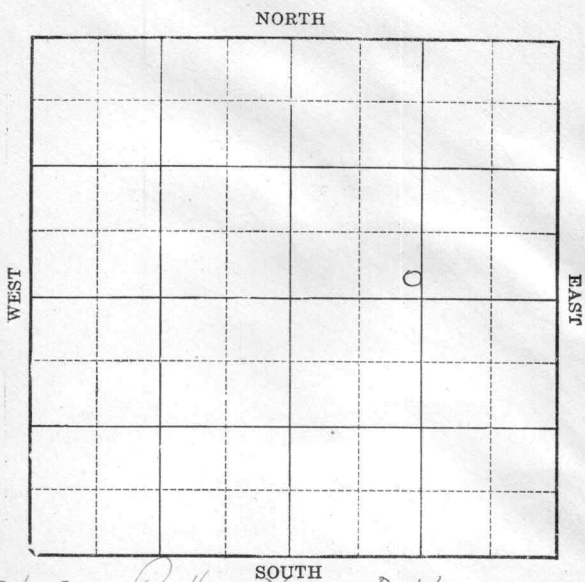

C-131k 25- College View Add

Location _____

Drilling Remarks _____

Rig Up _____

Drilling Remarks _____

RECORD

Cased _____ in. _____ ft.

Sand _____

Gas _____

Oil _____

Total Depth _____

PRODUCTION

1st 24 hrs. Nat. _____

1st 24 hrs. after shot _____

Gas _____ cu. ft.

Dry Hole _____

Abandoned _____


Cowley

Map No. KANSAS Sec. 22 Twp. 32 R. 4^E

Well No. 2- Ketto Farm

McKnabb et al Company

NORTH

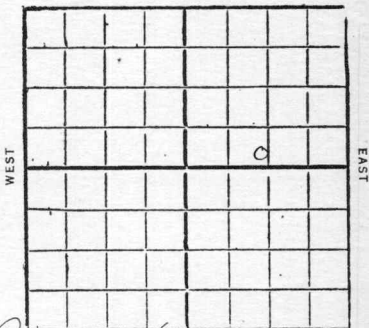

_____ Ft. from N. Line

150 Ft. from S. Line

_____ Ft. from E. Line

1300 Ft. from W. Line

1932 C. Bek 25- College View Add

Date REPORT

Date	REPORT
<u>2/3</u>	<u>Log</u>
<u>2/10</u>	<u>logs</u>
<u>2/17</u>	<u>run up</u>
<u>2/26</u>	<u>drill 400'</u>
<u>3/2</u>	<u>Drill 15"-469</u>
	<u>Drill 1146'</u>
<u>3/9</u>	<u>" 1675'</u>
<u>3/16</u>	<u>Drill 8"-2197</u>
<u>3/22</u>	<u>Drill 2839</u>
<u>3/30</u>	<u>Top sand 2988</u>
	<u>6"-2991</u>
	<u>Topline 3048-3229</u>
	<u>Helic line 3357-60</u>
	<u>show oil</u>
<u>4/6</u>	<u>TD 3360' No test</u>
<u>4/13</u>	<u>Helic line 3357-60</u>
	<u>TD 3360</u>
	<u>Runp 125 bbl oil</u>
	<u>Comp.</u>

Cowley

Map No. 2 Sec. 22 Twp. 32 R. 4 ^E

KANSAS

Well No. 2 Hutto

McKnabb et al Company

Contractor

FIRST REPORTS

SECTION PLAT

 Ft. from N. Line

150 Ft. from S. Line

 Ft. from E. Line

1300 Ft. from W. Line

@ Blk 25, College View add

Location ✓

Rig up

Drilling and Remarks:

RECORD

Cased in., ft.

Sand

Gas

Oil

Total Depth

PRODUCTION

1st 24 hrs. Nat.

1st 24 hrs. after shot

Gas Cu. Ft.

Dry Hole

Abandoned

Date FEB 3 1932

CHAS. L. SHERWOOD

Cowley

Map No. 2 KANSAS Sec. 22 Twp. 32 R. 4 ^E

Well No. 2 *Hutto*

McKnaha et al Company

Contractor

COMPLETED

SECTION PLAT

..... Ft. from N. Line

150 Ft. from S. Line

..... Ft. from E. Line

1300 Ft. from W. Line

Location.....

Rig up.....

Drilling and Remarks:

Pump 175 lbs

RECORD

Cased..... in., ft.

Sand *siliceous* 3357.60

Gas.....

Oil.....

Total Depth 3360

PRODUCTION

1st 24 hrs. Nat.....

1st 24 hrs. after shot.....

Gas..... Cu. Ft.

Dry Hole.....

Abandoned.....

Date

APR 13 1932

192

CHAS. L. SHERWOOD

Scout