


SUSAN

Section 3 Township 27 Range 6E
 Well No. #3 Songor- Holt
 Company W. H. Kimbal

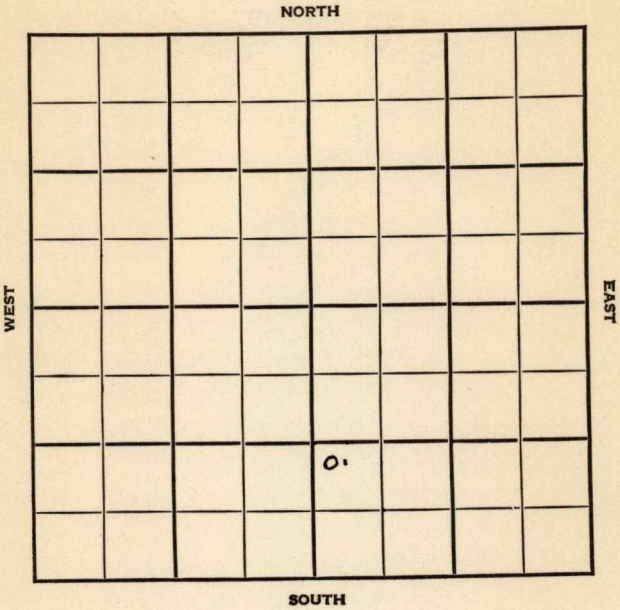

KANSAS

Butler

Sec. 3 Twp. 27 R. 6E

Well No. #3 Songor - Holt Farm

W. H. Kimbal Company


Misc.

 Ft. from N. Line

1200 Ft. from S. Line

 Ft. from E. Line

200 Ft. from W. Line

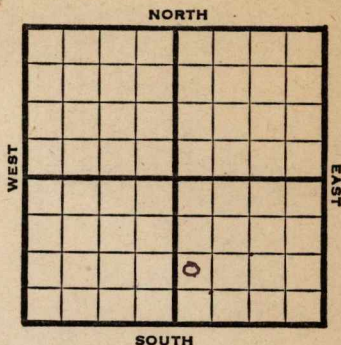

NW SW SE

1948

Elev. -

REPORT

1/21

8" @ 65'
Drlg. 1200'

1/26

Tight Hole

2/4

"

2/11

"

2/18

TD 2230'
5" @ 2230'
RUST

2/25

36 shots. 2214-26'
500 acid.

3/3

"

3/10

Sand 2202'
5" @ 2230'
Perf.
500 Acid
Pump 15 Pot.
Gr. 38°
TD 2230'

COMPLETED

Map No. _____ Sec. 3 Twp. 27 R. 6E

Well No. 3 Songor - Holt

W. H. Kimbal

Company _____

FIRST REPORT

Contractor _____

NW SW SE

SECTION PLAT

_____ Ft. from N. Line

1200 Ft. from S. Line

_____ Ft. from E. Line

200 Ft. from W. Line

Butler County

Location _____

Rig up _____

Drilling and Remarks:

8" @ 65

drlg. 1200

RECORD

Cased _____ in., _____ ft.

Sand _____

Gas _____

Oil _____

Total Depth _____

PRODUCTION

1st 24 hrs. Nat. _____

1st 24 hrs. after shot _____

Gas _____ Cu. Ft.

Dry Hole _____

Abandoned _____

Date

JAN 21 1948 19

S. J. LEWIS

Scout

Map No. 11 Sec. 3 Twp. 27 R. 6E

Well No. 3 Songor-Holt

W. H. Kimbal Company

COMPLETE Contractor

NW SW SE

SECTION PLAT

 Ft. from N. Line

1200 Ft. from S. Line

 Ft. from E. Line

200 Ft. from W. Line

		o	

Butler County

Location

Rig up

Drilling and Remarks:

Sand 1200.

5" 02230

Prof.

3000000

Aug 15 1948

05-2-48

RECORD

Cased in., ft.

Sand

Gas

Oil

Total Depth 2230

PRODUCTION

1st 24 hrs. Nat.

1st 24 hrs. after shot

Gas Cu. Ft.

Dry Hole

Abandoned

Date

MAR 10 1948

19

S. J. LEWIS Scout