


Map No. 15 Sec. 3 Twp. 27 R. 6
 Well No. 1 - Richardson Farm
~~Rosenthal et al~~ Company
Davis & Hazlett
 NORTH

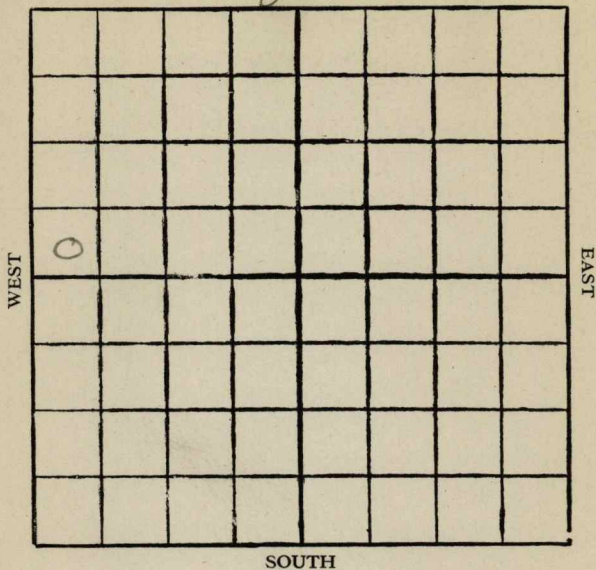

Location

Drilling Remarks

Rig Up

Drilling Remarks

RECORD

Cased in. ft.

Sand

Gas

Oil

Total Depth

PRODUCTION

1st 24 hrs. Nat.

1st 24 hrs. after shot

Gas cu. ft.

Dry Hole

Abandoned


Butler

Map No. 15 Sec. 3 Twp. 27 R. 6Well No. 1-Richardson Farm~~Rosenthal et al~~ Company
Davis + Hazlett

Ft. from N. Line

330 Ft. from S. Line

Ft. from E. Line

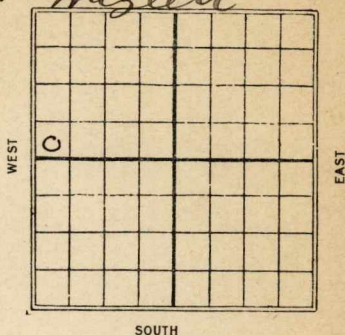330 Ft. from W. Line

1926

Date

REPORT

11/23 Location

12/8 rig

12/15 same

12/22 Drlg 300

12/30 " 750

1927

1/6 Drlg 1510

1/13 " 1875

1/19 " 2300

1/26 Top line 2804 T.D. 2810
1500' oil in hole

2/3 sand 2797-2806

30 bbls natural

11 **KANSAS** *Butler*
 Map No. _____ Sec. *3* Twp. *27* R. *6*
 Well No. *1* *Richardson*
Bodenthal @ *HH* _____ Company

Contractor _____

FIRST REPORTS**SECTION PLAT**

_____ Ft. from N. Line

330 _____ Ft. from S. Line

_____ Ft. from E. Line

330 _____ Ft. from W. Line

<i>0</i>			

Location *✓* _____

Rig up _____

Drilling and Remarks:

RECORD

Cased _____ in., _____ ft.

Sand _____

Gas _____

Oil _____

Total Depth _____

PRODUCTION

1st 24 hrs. Nat. _____

1st 24 hrs. after shot _____

Gas _____ Cu. Ft.

Dry Hole _____

Abandoned _____

Date

*NOV 23 1926***CHAS. L. SHERWOOD***192*

Scout

Map No. **KANSAS** Sec. **3** Twp. **27** R. **6**

Well No. **1 Richardson**
Savis & Hazlett Company

Contractor

COMPLETED**SECTION PLAT**

o			

Ft. from N. Line

330

Ft. from S. Line

Ft. from E. Line

330

Ft. from W. Line

Location

Rig up

Drilling and Remarks:

30 ft natural**RECORD**

Cased in., ft.

Sand **2797-2806**

Gas

Oil

Total Depth **2806****PRODUCTION**

1st 24 hrs. Nat.

1st 24 hrs. after shot

Gas Cu. Ft.

Dry Hole

Abandoned

Date

DEC 3 1927**192****CHAS. L. SHERWOOD**

Scout

11 **KANSAS** *Button*
 Map No. _____ Sec. *3* Twp. *27* R. *6*
 Well No. *1 Richardson*
Davis & Hazlett Company

Contractor _____

CORRECTION

_____ Ft. from N. Line

330 _____ Ft. from S. Line

_____ Ft. from E. Line

330 _____ Ft. from W. Line**SECTION PLAT**

<i>0</i>			

Location _____

Rig up _____ *✓*

Drilling and Remarks:

chg ownership
to Chava

RECORD

Cased _____ in., _____ ft.

Sand _____

Gas _____

Oil _____

Total Depth _____

PRODUCTION

1st 24 hrs. Nat. _____

1st 24 hrs. after shot _____

Gas _____ Cu. Ft.

Dry Hole _____

Abandoned _____

Date

DEC 8 1926**CHAS. L. SHERWOOD**

192

Scout