

Cowley


KANSAS

SECTION 22 TOWNSHIP 32 RANGE ~~4E~~ 4E

WELL NO. #1 Hutto-Biddle-Morton

COMPANY Beaumont Petr.

NORTH

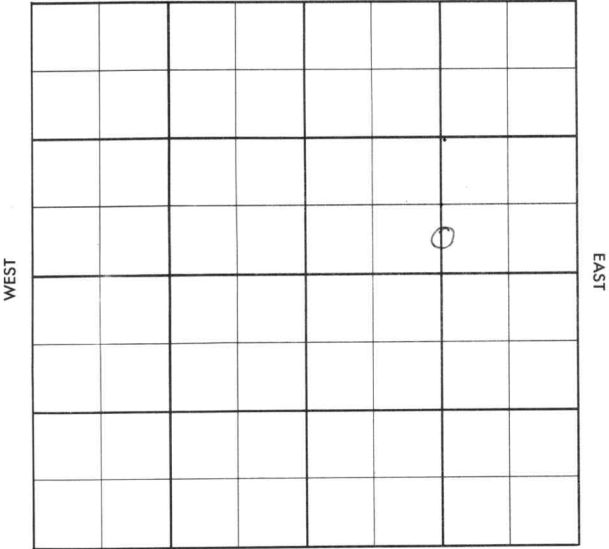

SOUTH

Cowley

KANSAS

SEC. 22	TWP. 32	R. 4E
------------	------------	----------

WELL NO.

#1 Hutto-Biddle-Morton

FARM

COMPANY

Beaumont Petr.

CONTRACTOR

Co. Tools

Winfield

Ft. from N. Line


Ft. from S. Line

Ft. from E. Line

Ft. from W. Line

C S  $\frac{1}{2}$  ~~SE~~ NE

( Cen. Blk 19)

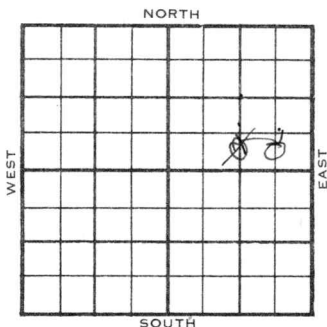

1956

ELEVATION

1248

REPORT

4-4

MIR

4-18

Comm. 4-5-56

10" @ 124 w/90

DST 2380-90 op 45 min. rec. 780' GIP

210' sw, 440#

DST 3010-30 op 1 hr. rec. 47' mud, 260#

D &amp; A

Layton 2377

Marm 2734

Bart 2991

B. Bart 3032

M. 3058

TD 3080'

ABANDONED



**CORRECTION**

County Cowley Elev. \_\_\_\_\_  
 Sec. 22 Twp. 32 Rge. 4E  
 Company Beaumont Pet.  
 Farm Name Hutton-Biddle-Morton No. 1

TOPS	DEPTH	LOG	DATUM
Anh.			
T.P.			
H.			
Tr.			
Dg.			
BL.			
L.			
K.C.			
B.K.C.			
Ce.			
C.			
M.			
M.			
K.			
Mz.			
Me.			
V.			
S.			
S.			
A.			
R.			
PE.			
G.			
T.D.			

Loc. in Sec. C S $\frac{1}{2}$  SE NE

Geol. \_\_\_\_\_

Contr. \_\_\_\_\_

Pool \_\_\_\_\_



Date Comm. APR 1 8 1956

Reported C S $\frac{1}{2}$  S $\frac{1}{2}$  NE

Co.

Lse.

No.

Sec.

T.

R.

County Cowley Elev. 1248 Co. Co.  
 Sec. 22 Twp. 32 Rge. 4E  
 Company Beaumont Pet.  
 Farm Name Hutto-Biddle-Morton No. 1

TOPS	DEPTH	LOG	DATUM	Loc. in Sec.
Anh.				C S <sup>1</sup> / <sub>2</sub> SE NE
T.P.				
H. <u>Layton</u>	<u>2377</u>		<u>1129</u>	
Tr.				
Dg.				
Bl. <u>Marm</u>	<u>2734</u>		<u>1486</u>	
L. <u>Bart</u>	<u>2991</u>		<u>1743</u>	Geol.
K.C. <u>B. Bart</u>	<u>3032</u>		<u>1784</u>	Contr.
B.K.C.				
Ce.				Co. tools
C.				
M.				Pool
M.	<u>3058</u>		<u>1810</u>	<u>Winfield</u>
K.				
Mz.				
Mq.				
V.				
S.				
S.				
A.				
R.				
PE.				
G.				
T.D.	<u>3080</u>			



Date Comm. 4-5-56 APR 18 1956  
 10" @ 124/90 DST 2380-90 open 45 min.  
 rec. 780' GIP 210' sw 440#  
 DST 3010-30 open 1 hr. rec. 47' mud  
 260#

D & A

Co.  
Lse.  
No.  
Sec.  
T.  
R.