

KANSAS


Form 51-5M-10-26-Mid-West

Cowley

Map No. Kansas Sec. 22 Twp. 32 R. 4

Well No. 1 mattison Farm

~~Patten & Fryett~~ Company  
~~McNabb et al~~ NORTH Roth & Fourat

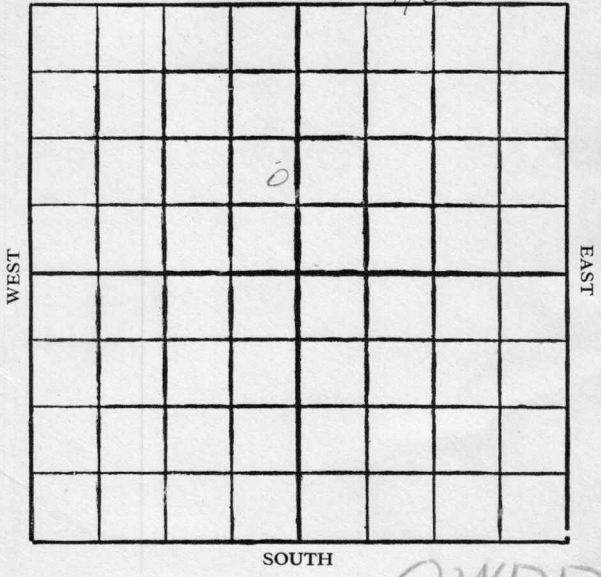

OWDID

Location .....

Rig Up.....

Drilling Remarks

Drilling Remarks

.....

.....

RECORD

PRODUCTION

Cased..... in. .... ft.

Sand .....

Gas .....

Oil .....

Total Depth.....

1st 24 hrs. Nat.....

1st 24 hrs. after shot.....

Gas..... cu. ft.

Dry Hole.....

Abandoned.....

Cowley

KANSAS


Map No. 15 Sec. 22 Twp. 32 R. 4

Well No. 1-Mattison Farm

~~Batter & Frye~~ Company

Lot 5 - Blk. 44  
Musgrove Add.

~~McNabb et al~~

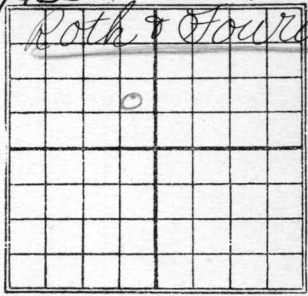

..... Ft. from N. Line

850 Ft. from S. Line

475 Ft. from E. Line

..... Ft. from W. Line

1927

Date

REPORT

3/9	Location
3/16	Rig
3/24	Drlg 390
3/30	" 1200
4/7	W.R. 10"-1695
4/13	Drlg 2070
4/20	Sand 2274-2302 4 1/2 mil gas. T.D. 2302
1927	O.W.D.D.
7/20	Drlg 2480
7/28	2484-2502 2 1/2 M gas T.D. 2502
1928	OWDD
2/15	Rigging up
2/23	
3/1	2908-2922 T.D. 2922 5 1/2 M gas (over)

1931

OWDD

12/22 - Old TD 2922

Cased 5" - 3295  
Silic line 3295-99  
TD 3299

flow 1100 bbl 14 hr  
Well pump

12/30 - T.D. 3307' line  
Well pump.

1932

1/6 - Cased 5" - 3295

Silic line 3295-3307  
T.D. 3307

Pump 500 bbl oil  
Comp.

*Cowley*

**2 KANSAS**

Map No. \_\_\_\_\_ Sec. *22* Twp. *32* R. *4*

Well No. *1* *Mattison*

*Pattee & Ryell* Company

Contractor

### FIRST REPORTS

### SECTION PLAT

\_\_\_\_\_ Ft. from N. Line

*850* Ft. from S. Line

*475* Ft. from E. Line

\_\_\_\_\_ Ft. from W. Line

*@ of lot 5 block 44*

*Musgrove addition*

	.		

Location

Rig up \_\_\_\_\_

Drilling and Remarks:

### RECORD

Cased \_\_\_\_\_ in., \_\_\_\_\_ ft.

Sand \_\_\_\_\_

Gas \_\_\_\_\_

Oil \_\_\_\_\_

Total Depth \_\_\_\_\_

### PRODUCTION

1st 24 hrs. Nat. \_\_\_\_\_

1st 24 hrs. after shot \_\_\_\_\_

Gas \_\_\_\_\_ Cu. Ft.

Dry Hole \_\_\_\_\_

Abandoned \_\_\_\_\_

Date

MAR 9

1927

CHAS. L. SHERWOOD

192

Scout

Map No. 2 **KANSAS** Sec. 22 Twp. 32 R. 4

Well No. 1 *Mattison*

*Ratter & Fryell* Company

Contractor

COMPLETED

SECTION PLAT

Ft. from N. Line

*850*

Ft. from S. Line

*475*

Ft. from E. Line

Ft. from W. Line

*Center of lots Bls 44  
marshgrove addition*

	o		

Location

Rig up

Drilling and Remarks:

*4 1/2 ft Sand*

*5 ft Well*

RECORD

Cased \_\_\_\_\_ in., \_\_\_\_\_ ft.

Sand *2274-2302*

Gas \_\_\_\_\_

Oil \_\_\_\_\_

Total Depth *2302*

PRODUCTION

1st 24 hrs. Nat. \_\_\_\_\_

1st 24 hrs. after shot \_\_\_\_\_

Gas *4 1/2 ft* Cu. Ft.

Dry Hole \_\_\_\_\_

Abandoned \_\_\_\_\_

Date

APR 20 1927

CHAS. L. SHERWOOD

192

Scout

**KANSAS**

Map No. \_\_\_\_\_ Sec. 22 Twp. 32 R. 4

Well No. 1 Madison

Mc Kabb @ 44 Company

Contractor

### FIRST REPORTS

### SECTION PLAT

\_\_\_\_\_ Ft. from N. Line

\_\_\_\_\_ Ft. from S. Line

\_\_\_\_\_ Ft. from E. Line

\_\_\_\_\_ Ft. from W. Line


Lot 7 Blk 44. Musgrove add.

Location \_\_\_\_\_

Rig up \_\_\_\_\_

Drilling and Remarks:

Dr 2480'

old well deeper

### RECORD

Cased \_\_\_\_\_ in., \_\_\_\_\_ ft.

Sand \_\_\_\_\_

Gas \_\_\_\_\_

Oil \_\_\_\_\_

Total Depth \_\_\_\_\_

### PRODUCTION

1st 24 hrs. Nat. \_\_\_\_\_

1st 24 hrs. after shot \_\_\_\_\_

Gas \_\_\_\_\_ Cu. Ft.

Dry Hole \_\_\_\_\_

Abandoned \_\_\_\_\_

Date

JUL 20 1927

192

**CHAS. L. SHERWOOD**

Scout

Spot well please

WANTS

Map No.

Well No.

Company

Contractor

SECTION PLAT


FIRST REPORTS

Ft. from N. Line

Ft. from S. Line

Ft. from E. Line

Ft. from W. Line

RECORD

Cased in, ft. \_\_\_\_\_  
 Sand \_\_\_\_\_  
 Gas \_\_\_\_\_  
 Oil \_\_\_\_\_  
 Total Depth \_\_\_\_\_

Location

Rig up

Drilling and Remarks:

PRODUCTION

1st 24 hrs. Net. \_\_\_\_\_  
 1st 24 hrs. after shot \_\_\_\_\_  
 Cr. Ft. \_\_\_\_\_  
 Hole \_\_\_\_\_  
 Abandoned \_\_\_\_\_

Returned \_\_\_\_\_  
 Cards \_\_\_\_\_  
 Tracing \_\_\_\_\_  
 Moody Map \_\_\_\_\_  
 Scarborough Map \_\_\_\_\_  
 Moody Map \_\_\_\_\_  
 Scarborough Plat Book \_\_\_\_\_  
 Moody Plat Book \_\_\_\_\_

*[Handwritten signature]*

*[Large X mark]*

SHERWOOD Scout

Date

JUL

*Cowley*

2 KANSAS Map No. \_\_\_\_\_ Sec. *22* Twp. *32* R. *4*

Well No. *1 Madison*  
*Mc Kabb* at 4W \_\_\_\_\_ Company

\_\_\_\_\_ Contractor

*@ lot 5 Bly 44*  
*Marygrove addition*

**SECTION PLAT**

**CORRECTION**

	0		

\_\_\_\_\_ Ft. from N. Line  
*850* \_\_\_\_\_ Ft. from S. Line  
*475* \_\_\_\_\_ Ft. from E. Line  
\_\_\_\_\_ Ft. from W. Line

*Formerly Patten & Jyell*

**RECORD**

Location \_\_\_\_\_  
Rig up \_\_\_\_\_

Cased \_\_\_\_\_ in., \_\_\_\_\_ ft.  
Sand \_\_\_\_\_  
Gas \_\_\_\_\_  
Oil \_\_\_\_\_  
Total Depth \_\_\_\_\_

Drilling and Remarks:  
*Previously reported*  
*in lot 7 Bly 44*

**PRODUCTION**

1st 24 hrs. Nat. \_\_\_\_\_  
1st 24 hrs. after shot \_\_\_\_\_  
Gas \_\_\_\_\_ Cu. Ft.  
Dry Hole \_\_\_\_\_  
Abandoned \_\_\_\_\_

*dry hole to choose*

Date  
**JUL 28 1927**

**CHAS. L. SHERWOOD**

*Cowley*

Map No. KANSAS Sec. 22 Twp. 32 R. 4

Well No. 1 Madison

*The Kaphs et al*

Company

Contractor

*@ hot's block 44  
Musgrove addition*

**SECTION PLAT**

**COMPLETED**


----- Ft. from N. Line

*850*

----- Ft. from S. Line

*475* ----- Ft. from E. Line

----- Ft. from W. Line

*old well drilled deeper.*

Location -----

Rig up -----

Drilling and Remarks:

*So. well*

**RECORD**

Cased \_\_\_\_\_ in., \_\_\_\_\_ ft.

Sand *7484-2502*

Gas -----

Oil -----

Total Depth *2502*

**PRODUCTION**

1st 24 hrs. Nat. -----

1st 24 hrs. after shot -----

Gas *2 1/2 M* Cu. Ft.

Dry Hole -----

Abandoned -----

Date

*JUL 28 1927*

**CHAS. L. SHERWOOD**

192

Scout

*Cowley*

2 KANSAS Sec. 22 Twp. 32 R. 4

Well No. 1 *Mattison*  
*McNabb et al* Company

Contractor

FIRST REPORTS

SECTION PLAT

----- Ft. from N. Line

*850* Ft. from S. Line

*475* Ft. from E. Line

----- Ft. from W. Line

*@ lot 5, Blk 44*

*Mesgrove addn.*

	o		

*Old Well Deeper.*

Location -----

Rig up *20 was 2502*

Drilling and Remarks:

*Rigging up to  
Drill Deeper*

RECORD

Cased ----- in., ----- ft.

Sand -----

Gas -----

Oil -----

Total Depth -----

PRODUCTION

1st 24 hrs. Nat. -----

1st 24 hrs. after shot -----

Gas ----- Cu. Ft.

Dry Hole -----

Abandoned -----

Date

FEB 15 1928

CHAS. L. SHERWOOD

Cowley

2 KANSAS  
 Map No. \_\_\_\_\_ Sec. 22 Twp. 32 R. 4

Well No. 1 Mattison

McNabb et al Company

Contractor

COMPLETED

SECTION PLAT

\_\_\_\_\_ Ft. from N. Line

850 Ft. from S. Line

475 Ft. from E. Line

\_\_\_\_\_ Ft. from W. Line

	o		

Location \_\_\_\_\_

Rig up \_\_\_\_\_

Drilling and Remarks:

gas well

RECORD

Cased \_\_\_\_\_ in., \_\_\_\_\_ ft.

Sand 2908-2922

Gas \_\_\_\_\_

Oil \_\_\_\_\_

Total Depth 2922

PRODUCTION

1st 24 hrs. Nat. \_\_\_\_\_

1st 24 hrs. after shot \_\_\_\_\_

Gas 5 1/2 AT Cu. Ft.

Dry Hole \_\_\_\_\_

Abandoned \_\_\_\_\_

Date

MAR 1 1928

CHAS. L. SHERWOOD

192

Scout

*Cawley*

2 **KANSAS**  
Map No. \_\_\_\_\_ Sec. *22* Twp. *32* R. *4*<sup>5</sup>

Well No. *1 Madison*

*Kath + Jaurat* Company

Contractor

FIRST REPORTS

SECTION PLAT


\_\_\_\_\_ Ft. from N. Line

*870* Ft. from S. Line

*450* Ft. from E. Line

\_\_\_\_\_ Ft. from W. Line

*not 5 Blk 44*

*Musgrove addn*

Location \_\_\_\_\_

Rig up \_\_\_\_\_

Drilling and Remarks:

*Allicious lime  
3295-3299  
glaw 1100 lbs  
14 Hours.  
Wire Pump*

RECORD

Cased *5"* in., *3295* ft.

Sand \_\_\_\_\_

Gas \_\_\_\_\_

Oil \_\_\_\_\_

Total Depth \_\_\_\_\_

PRODUCTION

1st 24 hrs. Nat. \_\_\_\_\_

1st 24 hrs. after shot \_\_\_\_\_

Gas \_\_\_\_\_ Cu. Ft.

Dry Hole \_\_\_\_\_

Abandoned \_\_\_\_\_

Date

*DEC 22 1931*

192

CHAS. L. SHERWOOD

Scout

Cowley

Map No. 2 KANSAS Sec. 22 Twp. 32 R. 4 <sup>E</sup>

Well No. 1 Madison

Roch & Faurat Company

Contractor

COMPLETE

SECTION PLAT

	0		

.....Ft. from N. Line

870 Ft. from S. Line

450 Ft. from E. Line

.....Ft. from W. Line

Rot 5 Blk 44  
Musgrove addn

Location.....

Rig up.....

Drilling and Remarks:

Pump 500 Bls.

RECORD

Cased 1.5" in., 3295 ft.

Sand Siliceous

Gas 3295-3307

Oil.....

Total Depth 3307

PRODUCTION

1st 24 hrs. Nat.....

1st 24 hrs. after shot.....

Gas.....Cu. Ft.

Dry Hole.....

Abandoned.....

Date

JAN 6 1932

CHAS. L. SHERWOOD

192.....

Scout