


Map No. _____ Sec. 3 Twp. 27 R. 6Well No. 1- Wallace FarmCrismet Oil Company

NORTH

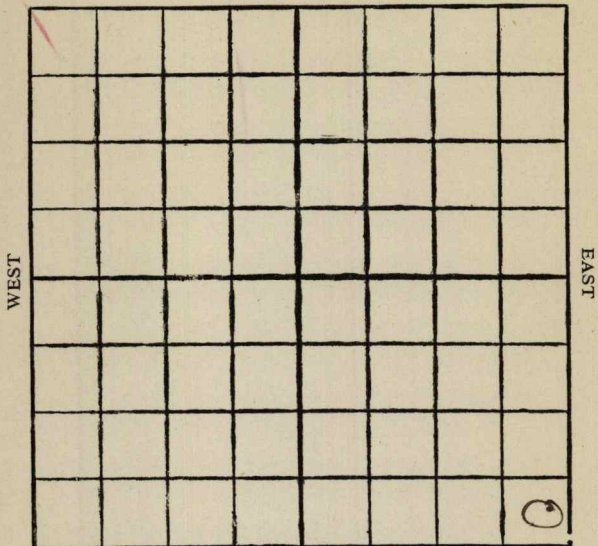

SOUTH

Location _____

Drilling Remarks _____

Rig Up _____

Drilling Remarks _____

RECORD

Cased _____ in. _____ ft.

Sand _____

Gas _____

Oil _____

Total Depth _____

PRODUCTION

1st 24 hrs. Nat. _____

1st 24 hrs. after shot _____

Gas _____ cu. ft.

Dry Hole _____

Abandoned _____

Map No. 11 KANSAS Sec. 3 Twp. 27 R. 6

Well No. 1 Wallas
Kismet Oil Co. Company
 Contractor

FIRST REPORTS


_____ Ft. from N. Line

330 _____ Ft. from S. Line

330 _____ Ft. from E. Line

_____ Ft. from W. Line

SECTION PLAT

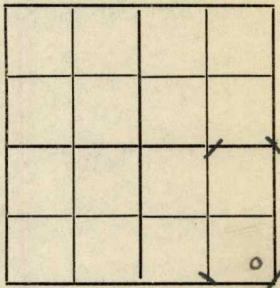

Location _____

Rig up ☒ _____

Drilling and Remarks:

RECORD

Cased _____ in., _____ ft.

Sand _____

Gas _____

Oil _____

Total Depth _____

PRODUCTION

1st 24 hrs. Nat. _____

1st 24 hrs. after shot _____

Gas _____ Cu. Ft.

Dry Hole _____

Abandoned _____

Date _____

JUN 22 1927 CHAS. L. SHERWOOD

192

Scout

11 **KANSAS** 3 *Butler*
 Map No. Sec. Twp. 27 R. 6
 Well No. 1 *Wallace*
Bisnet Oil Co. Company

Contractor

COMPLETED**SECTION PLAT**

			0

Ft. from N. Line

330 Ft. from S. Line

330 Ft. from E. Line

Ft. from W. Line

ABANDONED

Location

Rig up

Drilling and Remarks:

RECORD

Cased in., ft.

Sand

Gas

Oil

Total Depth

PRODUCTION

1st 24 hrs. Nat.

1st 24 hrs. after shot

Gas Cu. Ft.

Dry Hole

Abandoned *Location*

Date

SEP 14 1927

CHAS. L. SHERWOOD

192

Scout