


Section 4 Township 27 Range 6E

Well No. #2 Edwards

Company Murfin Drlg. Co.

NORTH

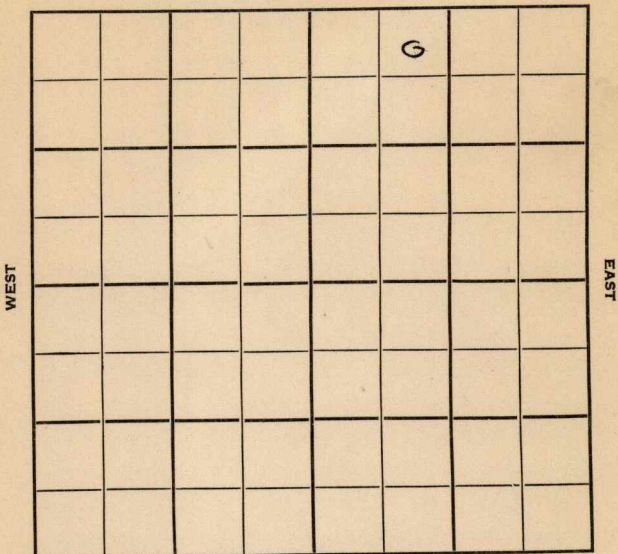

SOUTH

Sec. 4 Twp. 27 R. 6E

Well No. #2 Edwards Farm

Muffin Drlg. Co. Company

" Contractor


330 Ft. from N. Line

Ft. from S. Line

Ft. from E. Line

990 Ft. from W. Line

NE NW NE

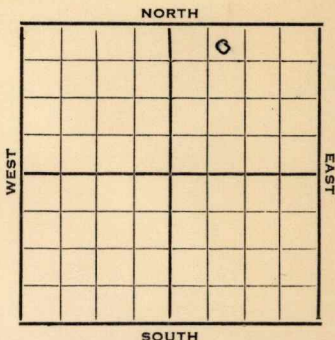

1952

Elev. 1417' REPORT

9/10 Location

11/19 Spud 10-18-52

Oil Well

TD 2795'

13" @ 372

10" @ 982

8" @ 2000

KC 2140, Miss 2783

SO 2786

5" @ 2785,

TD 2795

1000A

Comp. 25 bopd

COMPLETED

County Butler State Kansas

Sec. 4 (Blk. 27) (Sur. 6E) Map No.

Operator Murfin Drlg.

Well No. 2 Farm Edwards

Elev. 1417 Location NE NW NE

COMPLETE

330 Ft. From N Line NE

990 Ft. From W Line Quarter

Ist. Report

Completion NOV 19 1952

Remarks

Murfin Drlg. - Contr.

Spudding Date 10-18-52

Drlg. Data Oil well TD 2795

13" @ 372 10" @ 982 8" @ 2000

KC 2140 Miss. 2783 SO 2786 5" @ 2785

TD 2795 1000 A Comp. 25 bopd

