


Butler

Map No. _____ Sec. *4* Twp. *27* R. *6*

Well No. *1- Overton* Farm
Skelly oil Co Company

NORTH

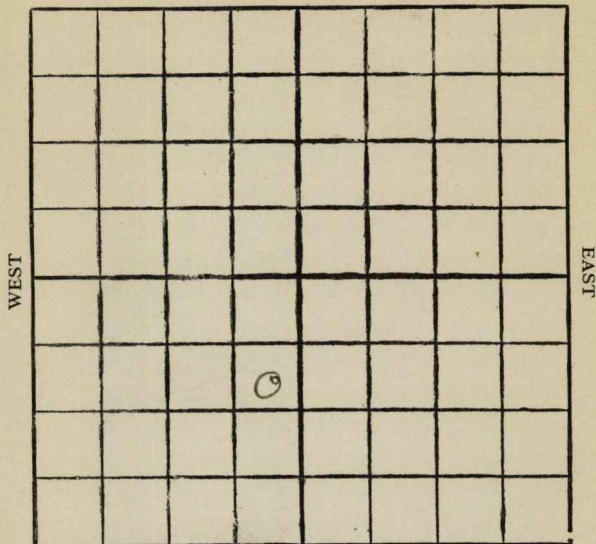

SOUTH

Location _____

Drilling Remarks _____

Rig Up _____

Drilling Remarks _____

RECORD

Cased _____ in. _____ ft.

Sand _____

Gas _____

Oil _____

Total Depth _____

PRODUCTION

1st 24 hrs. Nat. _____

1st 24 hrs. after shot _____

Gas _____ cu. ft.

Dry Hole _____

Abandoned _____

Butler

Map No. Sec. 4 Twp. 27 R 6

Well No. 1 - Overton Farm

Skelly Oil Co Company


NORTH

990 Ft. from N. Line

Ft. from S. Line

330 Ft. from E. Line

Ft. from W. Line

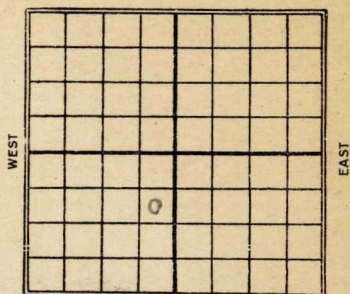

SOUTH

1927

Date

REPORT

4/13	Location
4/20	Timbers
4/27	Bldg rig
5/5	Spudding
5/12	Drlg 600
5/18	" 1200
5/25	" 1775
6/1	" 2275
6/7	top line 2753 show by log in
6/15	Top line 2753-75-1000' oil + water - Drlg 2900-
6/22	Drlg 3065-
6/29	Top line 2753-base 3074- 5"- 3096- Drlg 3105-
7/7	Top line 2753 Show oil 2753-75- Base line 3074 250 bbls

11 **KANSAS** Sec. 4 Twp. 27 R. 6
 Well No. 1 OVERTON

Skelley oil Co. Company

Contractor

FIRST REPORTS


SECTION PLAT

990 Ft. from N. Line

Ft. from S. Line

230 Ft. from E. Line

Ft. from W. Line

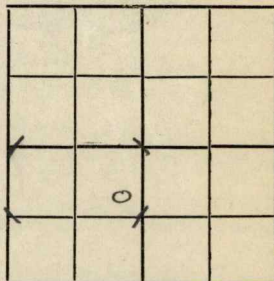

Location ✓

Rig up

Drilling and Remarks:

RECORD

Cased in., ft.

Sand

Gas

Oil

Total Depth

PRODUCTION

1st 24 hrs. Nat.

1st 24 hrs. after shot

Gas Cu. Ft.

Dry Hole

Abandoned

Date

APR 13 1927

CHAS. L. SHERWOOD

192

Scout

11 **KANSAS** Butlers
 Map No. 4 Sec. 27 Twp. 6 R. 6
 Well No. 1 Overton
 Kelly Oil Co. Company
 Contractor

COMPLETED

990 Ft. from N. Line

Ft. from S. Line

320 Ft. from E. Line

Ft. from W. Line

SECTION PLAT

Location

Rig up

Drilling and Remarks:

200' line 2753'

Show oil 2753-75

Base line 3074

250 Bl.

RECORD

Cased 3151 in., 3158 ft.

Sand 3151-3158

Gas

Oil

Total Depth 3158

PRODUCTION

1st 24 hrs. Nat.

1st 24 hrs. after shot

Gas Cu. Ft.

Dry Hole

Abandoned

Date

July 7 1927

CHAS. L. SHERWOOD

Scout