


Form 51-5M-2-29-34703

Map No. *Cowley* KANSAS Sec. *22* Twp. *32* R. *4E*

Well No. *4 - Northwestern College* Farm  
*Both & Fowrat* Company

NORTH

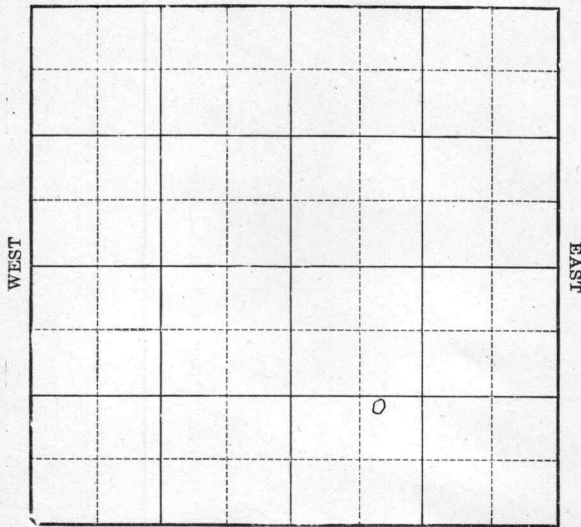

SOUTH

*Lot 8 - Blk 37 College Hill Add.*

Location \_\_\_\_\_

Drilling Remarks \_\_\_\_\_

Rig Up \_\_\_\_\_

Drilling Remarks \_\_\_\_\_

RECORD

Cased \_\_\_\_\_ in. \_\_\_\_\_ ft.

Sand \_\_\_\_\_

Gas \_\_\_\_\_

Oil \_\_\_\_\_

Total Depth \_\_\_\_\_

PRODUCTION

1st 24 hrs. Nat. \_\_\_\_\_

1st 24 hrs. after shot \_\_\_\_\_

Gas \_\_\_\_\_ cu. ft.

Dry Hole \_\_\_\_\_

Abandoned \_\_\_\_\_

Map No. KANSAS Sec. 22 Twp. 32 R. 4E


Well No. 4 Southwestern College Farm  
Both & Howat Company

.....Ft. from N. Line

1250 Ft. from S. Line

.....Ft. from E. Line

800 Ft. from W. Line

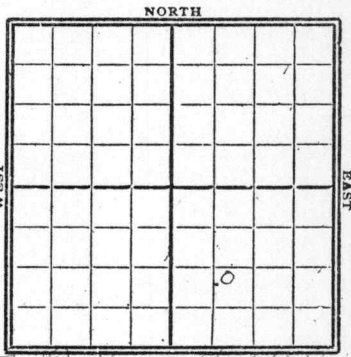

1932 Lot 8-131K 37 College Hill Add

Date

REPORT

6/8	Ops.
6/15	Spdg.
6/22	15"-432 Dreg 650'
6/29	12"-1018 Dreg 1480'
7/6	<del>File line 3297-3307</del> <del>Show oil</del>
7/13	<del>SD 3307 (error)</del>
7/20	
7/27	Correction TD 1885 Spidding rig
8/3	Whedded Rig 40 ft NW
8/10	set 15"-460'
8/17	Dreg 1450
8/24	12"-1015 TD 1785' UIC 10"
8/31	dreg 1940'
9/7	8"-2182 Top sand 2350 show oil - dreg in

9/14 - 3 bails water 2350-2450

HFN 2565

drlg 2750

9/21 - " " 2940'

9/30 - " 6" - 2976

Sand 2976-3010

shaw gas

top line 3010

drlg 3050

10/5 - Silic line 3311-23

TD 3323

Pump 30 bbl

Comp.

*Cawley*

E

Map No. KANSAS Sec. 22 Twp. 32 R. H

Well No. 4 Southwestern College  
North & Faurer Company

Contractor

### FIRST REPORTS

..... Ft. from N. Line

1750 Ft. from S. Line

..... Ft. from E. Line

800 Ft. from W. Line

### SECTION PLAT


Lot 8 Blk 37  
College Hill addn  
Location.....

Rig up.....

Drilling and Remarks:

Pro 4

### RECORD

Cased..... in., ..... ft.

Sand.....

Gas.....

Oil.....

Total Depth.....

### PRODUCTION

1st 24 hrs. Nat.....

1st 24 hrs. after shot.....

Gas..... Cu. Ft.

Dry Hole.....

Abandoned.....

Date

JUN 8 1932

**CHAS. L. SHERWOOD**

..... 192..... Scout

*Cowley*

E

Map No. *2* **KANSAS** Sec. *22* Twp. *32* R. *4*

Well No. *Southwestern College*

*Ruth & James* Company

Contractor

COMPLETED

SECTION PLAT


Ft. from N. Line

*1250* Ft. from S. Line

Ft. from E. Line

*800* Ft. from W. Line

RECORD

Location

Cased *5 1/2* in., *3311-23* ft.

Rig up

Sand *5 1/2* *3311-23*

Drilling and Remarks:

Gas

Oil

Total Depth *3323*

PRODUCTION

1st 24 hrs. Nat.

1st 24 hrs. after shot

Gas *3323* Cu. Ft.

Dry Hole

Abandoned

*Pump 30 Bl*

Date

OCT 5 1932

CHAS. L. SHERWOOD

192 Scout