


Map No. 11-1 Sec. 22 Twp. 32 R. 4
 Well No. 1- Reynolds Wallace Farm
McNabb et al Company

150 Ft. from N. Line

..... Ft. from S. Line

150 Ft. from E. Line

..... Ft. from W. Line

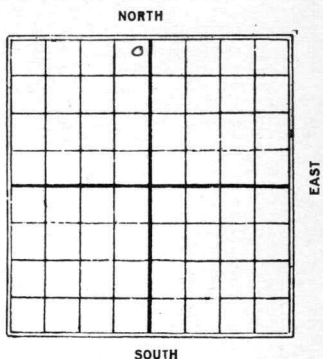

1926

Date	REPORT
10/20	location
10/27	timbers
11/11	Bldg rig
11/17	rigging up
11/23	Spudg
12/8	Drlg 1350
12/15	Underreaming 1715'
12/22	Drlg 2000
12/30	And 2297-2357 Dry drlg.
<u>1927</u>	
1/6	sand 2297-2374 oil 2357-74 160/50 bbls
1928	OWDD T.D. 2374'
9/26	Rign up.
10/3	
10/10	Drlg 2390'
10/17	" 2915'
10/24	sand 2941-88' shot 20 grs - 3M gas 55 bbls oil
10/31	50 bbls oil

11/7- sand 2941-88'

T.D. 2988'

shot 20 gts

25 bbls oil

2 M cu ft gas

Pump

Cowley

2 KANSAS 22 Map No. Sec. 22 Twp. 32 R. 4

Well No. 1 Reynolds
McNabb et al Company

Contractor

FIRST REPORTS

SECTION PLAT

150 Ft. from N. Line

Ft. from S. Line

150 Ft. from E. Line

Ft. from W. Line

	o		

Location ✓

Rig up

Drilling and Remarks:

RECORD

Cased in., ft.

Sand

Gas

Oil

Total Depth

PRODUCTION

1st 24 hrs. Nat.

1st 24 hrs. after shot

Gas Cu. Ft.

Dry Hole

Abandoned

Date

OCT 20 1926

CHAS. L. SHERWOOD

192

Scout

Cowley

2 KANSAS Sec. 22 Twp. 32 R. 4

Well No. 1 Reynolds

The Nubb et al Company

Contractor

COMPLETED

SECTION PLAT

150 Ft. from N. Line

Ft. from S. Line

150 Ft. from E. Line

Ft. from W. Line

	o		

Location

Rig up

Drilling and Remarks:

oil 2357-74

16 1/2 50 lbs.

RECORD

Cased in., ft.

Sand 2297-2374

Gas

Oil

Total Depth 2374

PRODUCTION

1st 24 hrs. Nat.

1st 24 hrs. after shot

Gas Cu. Ft.

Dry Hole

Abandoned

Date JAN 6 1927

CHAS. L. SHERWOOD

Cowley

K2 KANSAS

MAP No. _____ SEC. 22 TWP. 32 R. 4

WELL No. _____

*Wallace
W. W. Mc Nab*

COMPANY _____

CONTRACTOR _____

FIRST REPORTS

SECTION PLAT

	0		

750 FT. FROM N. LINE

_____ FT. FROM S. LINE

750 FT. FROM E. LINE

_____ FT. FROM W. LINE

"Old Well Deeper"

LOCATION _____

RIG UP _____

DRILLING AND REMARKS:

Rigging up

T.D. 2374'

RECORD

CASED _____ IN., _____ FT.

SAND _____

GAS _____

OIL _____

TOTAL DEPTH _____

PRODUCTION

1ST 24 HRS. NAT. _____

1ST 24 HRS. AFTER SHOT _____

GAS _____ CU. FT.

DRY HOLE _____

ABANDONED _____

DATE

SEP 26 1928

CHAS. L. SHERWOOD
192 _____ SCOUT

Cowley

K2 KANSAS

MAP NO. _____ SEC. 22 TWP. 32 R. 4

WELL NO. 1

Wallace
W. M. Mc Nab

COMPANY _____

CONTRACTOR _____

COMPLETED SECTION PLAT

250 FT. FROM N. LINE

_____ FT. FROM S. LINE

250 FT. FROM E. LINE

_____ FT. FROM W. LINE

	0		

LOCATION _____

RIG UP _____

DRILLING AND REMARKS:

20/25 H₂O def
2 A Gas

RECORD

CASED _____ IN. _____ FT.

SAND 2941-2988

GAS _____

OIL _____

TOTAL DEPTH 2988

PRODUCTION

1ST 24 HRS. NAT. _____

1ST 24 HRS. AFTER SHOT _____

GAS _____ Cu. Ft.

DRY HOLE _____

ABANDONED _____

DATE
NOV 7 1928

CHAS. L. SHERWOOD

192 _____ SCOUT