

KANSAS

Butler

FORM 51 5M PETROL

Section 4 Township 27 Range 6E ~~7E~~

Well No. 1 Beetle

Company S & L Drlg.

NORTH

0							

SOUTH

WEST EAST

KANSAS

Butler

6E
7-E

Sec. 4 Twp. 27 R. 7-E

Well No. #1 Beetle Farm

S & L Drlg. Company


Ft. from N. Line

330 Ft. from S. Line

Ft. from E. Line

330 Ft. from W. Line

SW/c

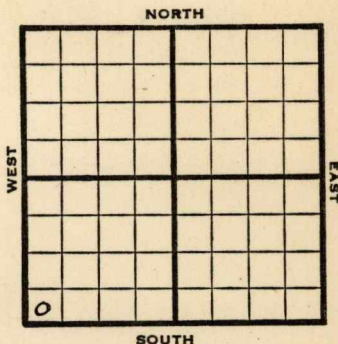

1945 **Elev. 1400'** REPORT

10/10 cable

10/17 Rig

10/24 Drlg. 500'

10/31 12" @ 600

Drlg. 1250

11/7 10" @ 1630

Drlg. 1670'

11/14 Drlg. 2075'

11/21 8" @ 2310

Drlg. 2455

11/28 **Miss. 2838**

TD 2875 UR 6"

12/5 Drlg. 3040'

12/12 5" @ 3135

Viola 3145-3160

TD 3160 SO & W

12/20 Plugging back.

12/29 " "

1946

1/9 **Viola 3145**

5" @ 3135

1000 acid.

TD 3160

Pump 20 oil plus 150 Wtr. Pot.


Grav. 38.0

COMPLETED

KANSAS Pool Name MiscellaneousMap No. 10 Sec. 4 Twp. 27 R. 7EWell No. 1 BeetleS & L Drlg. CompanyFIRST REPORT Contractor

SW/c

SECTION PLAT

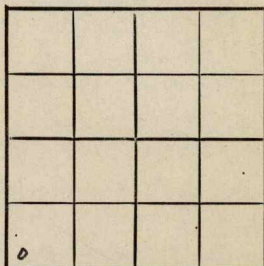 Ft. from N. Line330 Ft. from S. Line Ft. from E. Line330 Ft. from W. LineButler CountyLocationRig upDrilling and Remarks:
cable

RECORD

Cased in., ft.Sand Gas Oil Total Depth

PRODUCTION

1st 24 hrs. Nat. 1st 24 hrs. after shot Gas Cu. Ft.Dry Hole Abandoned

Date

OCT 10 1945 19S. J. LEWIS

Scout

KANSASKansas Pool Name MiscellaneousMap No. 11 Sec. 4 Twp. 27 R. 6EWell No. 1 BeetleS & L Drlg.

Company

CORRECTION

Contractor

SW/c

SECTION PLAT

0			

Ft. from N. Line330 Ft. from S. LineFt. from E. Line330 Ft. from W. LineButler County

Location _____

Rig up _____

Drilling and Remarks:

reported 4-27-7E

RECORD

Cased _____ in., _____ ft.

Sand _____

Gas _____

Oil _____

Total Depth _____

PRODUCTION

1st 24 hrs. Nat. _____

1st 24 hrs. after shot _____

Gas _____ Cu. Ft.

Dry Hole _____

Abandoned _____

Date

OCT 3 1 1945

19

S. J. LEWIS

Scout

KANSASKansas Pool Name miscellaneousMap No. 11 Sec. 4 Twp. 27 R. 6EWell No. 1 Beetle

S & L Drlg.

Company

COMPLETED

Contractor

SW/c

E11400**SECTION PLAT**

0			

 Ft. from N. Line330 Ft. from S. Line Ft. from E. Line330 Ft. from W. Line**Butler County**Location Rig up

Drilling and Remarks:

102231455" @ 31351000 acc'dPump 20 in + 150Water 2 ft38-20**RECORD**Cased in., ft.Sand Gas Oil Total Depth 3160**PRODUCTION**1st 24 hrs. Nat. 1st 24 hrs. after shot Gas Cu. Ft.Dry Hole Abandoned

Date

JAN 9 1946 19

S. J. LEWIS

Scout