


Cowley

Map No. *17 N* Sec. *22* Twp. *32* R. *4*

Well No. *1* *Reynolds* Farm
J. B. Slick Company

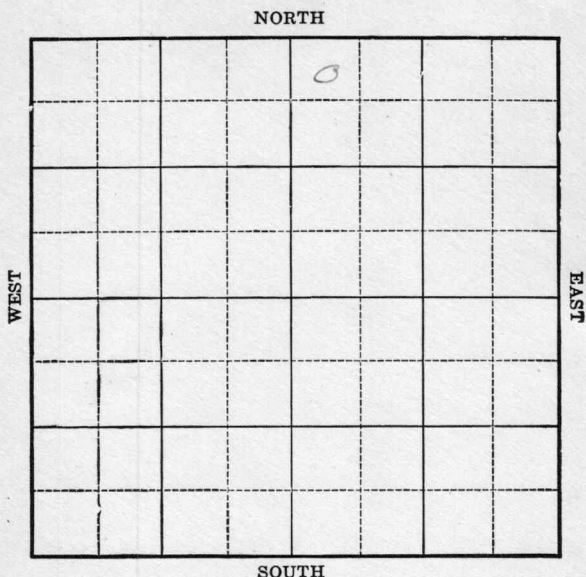

Location _____

Drilling Remarks

RECORD

Cased _____ in. _____ ft.

Sand _____

Gas _____

Oil _____

Total Depth _____

Rig Up _____

Drilling Remarks

PRODUCTION

1st 24 hrs. Nat. _____

1st 24 hrs. after shot _____

Gas _____ cu. ft.

Dry Hole _____

Abandoned _____


Map No. Kansas Sec. 22 Twp. 32 R. 4
 Well No. 1 Reynolds Farm
J. B. Slick Company

230 Ft. from N. Line

_____ Ft. from S. Line

_____ Ft. from E. Line

330 Ft. from W. Line

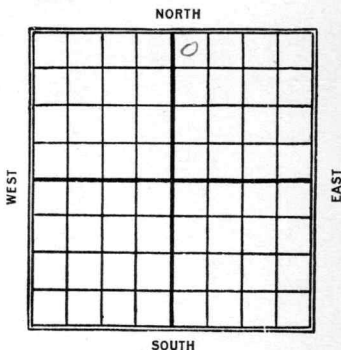

Date

REPORT

1926

8/18 Location

8/25 rig

8/31 rig up

9/15 Drilg 1050'

9/22 " 1600

9/29 " 1800

10/13 Sand 2320-97' gas

2343' Oil 2395'

spraying 25-40 bbls per day.

10/20 Sand 2380-2392

20/200 bbls

2 KANSAS Cowley 32 4
 Map No. _____ Sec. 22 Twp. _____ R. _____
 Well No. 1 Reynolds
 T. B. Slicks _____ Company

Contractor

FIRST REPORTS

SECTION PLAT

330 _____ Ft. from N. Line

_____ Ft. from S. Line

_____ Ft. from E. Line

330 _____ Ft. from W. Line

		0	

Location ✓ _____

Rig up _____

Drilling and Remarks:

RECORD

Cased _____ in., _____ ft.

Sand _____

Gas _____

Oil _____

Total Depth _____

PRODUCTION

1st 24 hrs. Nat. _____

1st 24 hrs. after shot _____

Gas _____ Cu. Ft.

Dry Hole _____

Abandoned _____

Date

AUG 18 1926

CHAS. L. SHERWOOD

192

Scout

Cowley
 2 KANSAS 22 32 4
 Map No. Sec. Twp. R.

Well No. 1 Reynolds
 T. B. Slicks Company

Contractor

COMPLETED

SECTION PLAT

330 Ft. from N. Line

Ft. from S. Line

Ft. from E. Line

330 Ft. from W. Line

		0	

Location

Rig up

Drilling and Remarks:

24
 200 Bl.

RECORD

Cased in. ft.

Sand 2380-2392

Gas

Oil

Total Depth 2392

PRODUCTION

1st 24 hrs. Nat.

1st 24 hrs. after shot

Gas Cu. Ft.

Dry Hole

Abandoned

Date

OCT 20 1926

CHAS. L. SHERWOOD

192

Scout