

Section 4 Township 27 Range 6 EWell No. # 1 IrelandCompany Murfin Drlg. et al

NORTH

			0				

WEST

EAST

SOUTH

Butler

KANSAS


 Sec. 4 Twp. 27 R. 6E

 Well No. #1 Ireland Farm

Murfin Drlg. et al Company


Murfin Drlg. Contractor
Reynolds-Schaffer
 Ft. from N. Line

990 Ft. from S. Line

330 Ft. from E. Line

 Ft. from W. Line

NE SE NW

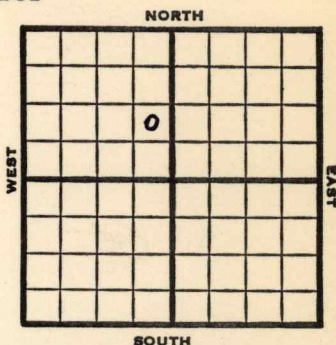

1953

Elev. 1404'

REPORT

5/13 Location

 6/24 Spud 5-23-53
 Oil Well
 TD 2794
 13" @ 370
 10" @ 1065
 KC 2128
 8" @ 2125
 Miss 2770
 7" @ 2772
 TD 2794
 1000A
 Comp. 25 bopd

COMPLETED

County Butler State KansasSec. 4- (Blk.) 27 (Sur.) 6E Map No.Operator Murfin Drlg. etal.Well No. 1 Farm IrelandElev. 1404 Location NE SE NW990 Ft. From S Line NW330 Ft. From E Line Quarter1st. ReportCompletion JUN 24 1953Remarks Reynolds-SchafferMurfin Drlg. - Contr.Spudding Date 5-23-53Drlg. Data Oil well TD 279413" @ 370 10" @ 1065 KC 21288" @ 2125 Miss. 2770 7" @ 2772TD 2794 1000 A Comp. 25 bopd