


Well No. 2 - Overton Farm

Tom C. Johnson Company

NORTH

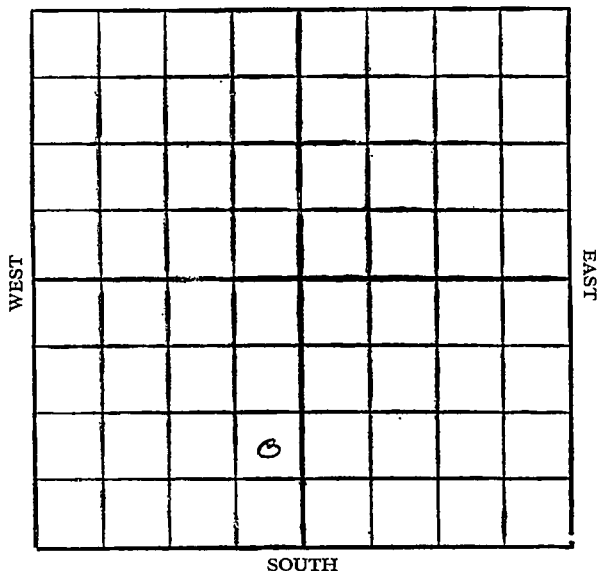

Drilling Remarks

Drilling Remarks

PRODUCTION

1st 24 hrs. Nat.....

1st 24 hrs. after shot.....

Gas..... cu. ft.

Dry Hole.....

Abandoned

11 KANSAS
 Map No. _____ Sec. 4 Twp. 27 R. 6
 Well No. 2 Overton
 Tom. C. Johnson Company

Contractor

FIRST REPORTS


SECTION PLAT

_____ Ft. from N. Line

990 _____ Ft. from S. Line

330 _____ Ft. from E. Line

_____ Ft. from W. Line

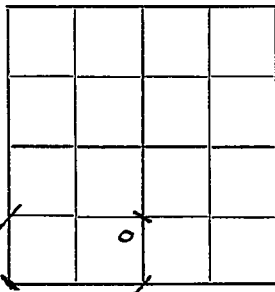

Location _____

Rig up ☒

Drilling and Remarks:

RECORD

Cased _____ in., _____ ft.

Sand _____

Gas _____

Oil _____

Total Depth _____

PRODUCTION

1st 24 hrs. Nat. _____

1st 24 hrs. after shot _____

Gas _____ Cu. Ft.

Dry Hole _____

Abandoned _____

Date

FEB 10 1927

CHAS. L. SHERWOOD

192

Scout

11 **KANSAS** Sec. 4 Twp. 27 R. 6

Well No. 2 Overton
Tom. C. Johnson Company

Contractor

COMPLETED


SECTION PLAT

----- Ft. from N. Line

990 Ft. from S. Line

330 Ft. from E. Line

----- Ft. from W. Line

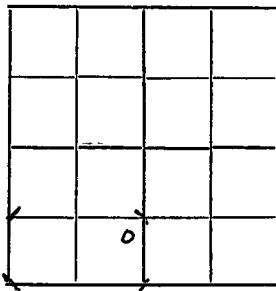

Location -----

Rig up -----

Drilling and Remarks:

Top line 2780-3070

Band 3134-43 1/2

250 Bls.

RECORD

Cased ----- in., ----- ft.

Sand -----

Gas -----

Oil -----

Total Depth 3143 1/2

PRODUCTION

1st 24 hrs. Nat. -----

1st 24 hrs. after shot -----

Gas ----- Cu. Ft.

Dry Hole -----

Abandoned -----

Date

APR 13 1927

CHAS. L. SHERWOOD

192

Scout