


Cowley

Map No. _____ Sec. *22* Twp. *32R* *4*

Well No. *3 - Wallace* Farm
Mc Nabbs et al Company

NORTH

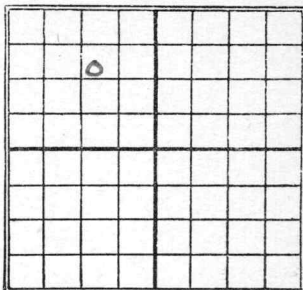

_____ Ft. from N. Line

Lot 15 _____ Ft. from S. Line

_____ Ft. from E. Line

_____ Ft. from W. Line

SOUTH

1927

Date

REPORT

<i>6/1</i>	<i>Location</i>
<i>6/7</i>	<i>Run up</i>
<i>6/15</i>	<i>Drig 780</i>
<i>6/22</i>	<i>" 1200</i>
<i>6/29</i>	<i>u.R. 10" - 1790-</i>
<i>7/13</i>	<i>2322 - 2352</i>
	<i>Oil 2330'</i>
	<i>50 gts / 150 bbls</i>

Cowley

Map No. 2 KANSAS Sec. 22 Twp. 32 R. 4

Well No. 3 *Wallace*

McNabb et al Company

Contractor

FIRST REPORTS

SECTION PLAT

----- Ft. from N. Line

----- Ft. from S. Line

----- Ft. from E. Line

----- Ft. from W. Line

Lot 5 Kingsbridge Addition.

	0		

Location -----

Rig up -----

Drilling and Remarks:

RECORD

Cased ----- in., ----- ft.

Sand -----

Gas -----

Oil -----

Total Depth -----

PRODUCTION

1st 24 hrs. Nat. -----

1st 24 hrs. after shot -----

Gas ----- Cu. Ft.

Dry Hole -----

Abandoned -----

Date

JUN 1 1927

CHAS. L. SHERWOOD

Cowley

Map No. 2 KANSAS Sec. 22 Twp. 22 R. 4

Well No. 3 *wallace*

McKabb @ *TK* Company

Contractor

COMPLETED

SECTION PLAT

----- Ft. from N. Line

----- Ft. from S. Line

----- Ft. from E. Line

----- Ft. from W. Line

Lot 5, Kingshield addition

Location -----

Rig up -----

Drilling and Remarks:

Oil 2230'

507 150 Bls.

RECORD

Cased ----- in., ----- ft.

Sand 2222-2352'

Gas -----

Oil -----

Total Depth 2352

PRODUCTION

1st 24 hrs. Nat. -----

1st 24 hrs. after shot -----

Gas ----- Cu. Ft.

Dry Hole -----

Abandoned -----

Date

July 13 1927

CHAS. L. SHERWOOD

Scout