


Map No. _____ Sec. 4 Twp. 27 R. 6
 Well No. 1 Shaffer Farm
Rosenthal & Laseen Company

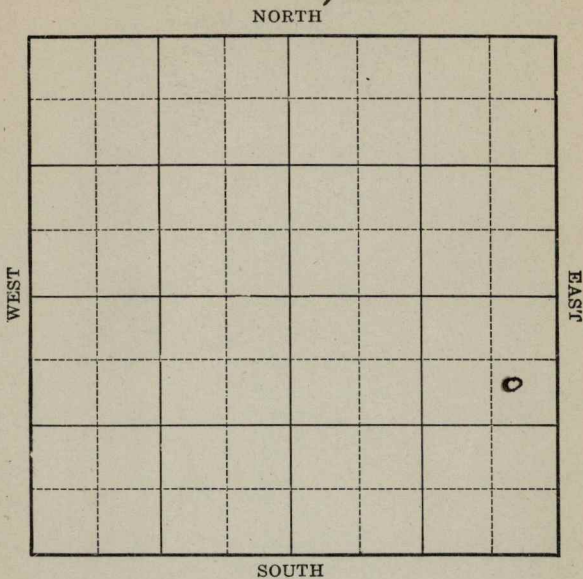

Location _____

Drilling Remarks _____

RECORD

Cased _____ in. _____ ft.

Sand _____

Gas _____

Oil _____

Total Depth _____

Rig Up _____

Drilling Remarks _____

PRODUCTION

1st 24 hrs. Nat. _____

1st 24 hrs. after shot _____

Gas _____ cu. ft.

Dry Hole _____

Abandoned _____

Butler

K 11 KANSAS

Map No. _____ Sec. 4 Twp. 27 R. 6

Well No. 7 Shaffer

Rosenthal & Lassen Company

Contractor

FIRST REPORTS

SECTION PLAT

990 Ft. from N. Line

Ft. from S. Line

330 Ft. from E. Line

Ft. from W. Line

			0

Location Ros

Rig up

Drilling and Remarks:

RECORD

Cased _____ in., _____ ft.

Sand _____

Gas _____

Oil _____

Total Depth _____

PRODUCTION

1st 24 hrs. Nat. _____

1st 24 hrs. after shot _____

Gas _____ Cu. Ft.

Dry Hole _____

Abandoned _____

Date

SEP 1 - 1927 CHAS. L. SHERWOOD

192

Scout

11 **KANSAS** Butter
 Map No. _____ Sec. 4 Twp. 27 R. 6

Well No. 7 Shaffer
Rosenthal & Kassen Company

Contractor

COMPLETED

SECTION PLAT

990 Ft. from N. Line

_____ Ft. from S. Line

330 Ft. from E. Line

_____ Ft. from W. Line

Location _____

Rig up _____

Drilling and Remarks:

200 fts.

RECORD

Cased _____ in. _____ ft.

Sand 3160-3168

Gas _____

Oil _____

Total Depth 3168

PRODUCTION

1st 24 hrs. Nat. _____

1st 24 hrs. after shot _____

Gas _____ Cu. Ft.

Dry Hole _____

Abandoned _____

Date

OCT 26 1927

192

CHAS. L. SHERWOOD

Scout