


Butler

Form 51-5M-4-27-27423

Map No. KANSAS Sec. 4 Twp. 27 R. 6<sup>E</sup>

Well No. 11 Schaffer Farm  
Rosenthal et al Company

NORTH

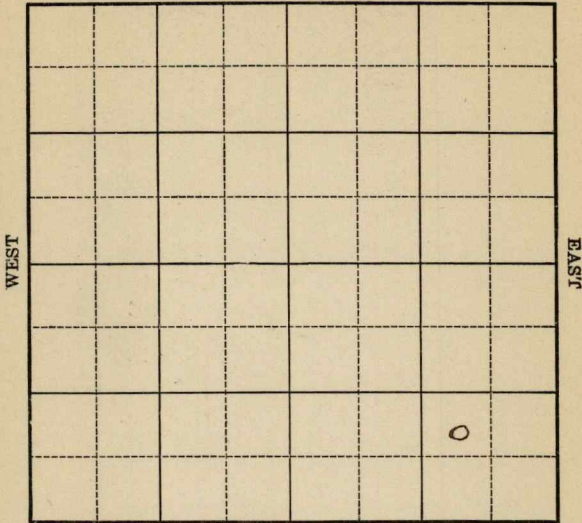

SOUTH

Location \_\_\_\_\_  
Drilling Remarks \_\_\_\_\_

Rig Up \_\_\_\_\_  
Drilling Remarks \_\_\_\_\_

\_\_\_\_\_  
\_\_\_\_\_  
**RECORD**

**PRODUCTION**

Cased \_\_\_\_\_ in. \_\_\_\_\_ ft.  
Sand \_\_\_\_\_  
Gas \_\_\_\_\_  
Oil \_\_\_\_\_  
Total Depth \_\_\_\_\_


1st 24 hrs. Nat. \_\_\_\_\_  
1st 24 hrs. after shot \_\_\_\_\_  
Gas \_\_\_\_\_ cu. ft.  
Dry Hole \_\_\_\_\_  
Abandoned \_\_\_\_\_

Butler

Map No. Kansas Sec. 4 Twp. 27 R. 6<sup>E</sup>

Well No. 11 Schaffer Farm  
Rosenthal et al Company

..... Ft. from N. Line  
990 Ft. from S. Line  
990 Ft. from E. Line  
..... Ft. from W. Line

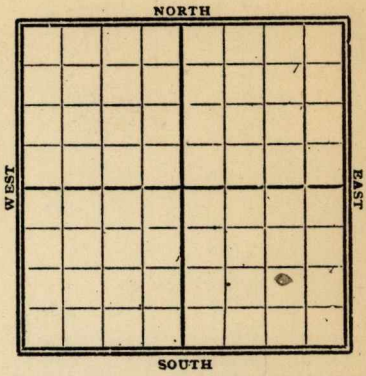

Date	REPORT
1928	
8/8	Rigging up
8/16	Spudding
8/23	Drlg 1100
8/28	" 2000
9/4	" 2740
9/12	Top line 2755
	Drlg. 3055
9/19	_____
9/26	_____
10/3	sand 3145-58' T.D.
	T.L. 2755
	200 bbls
	Comp

Butler

E

11 KANSAS

Map No. \_\_\_\_\_ Sec. 4 Twp. 27 R. 6

Well No. 11 Schager

Rosenthal et al Company

Contractor

FIRST REPORTS

SECTION PLAT

\_\_\_\_\_ Ft. from N. Line

990 Ft. from S. Line

990 Ft. from E. Line

\_\_\_\_\_ Ft. from W. Line

			0

Location \_\_\_\_\_

Rig up \_\_\_\_\_

Drilling and Remarks:

Rigging up

RECORD

Cased \_\_\_\_\_ in., \_\_\_\_\_ ft.

Sand \_\_\_\_\_

Gas \_\_\_\_\_

Oil \_\_\_\_\_

Total Depth \_\_\_\_\_

PRODUCTION

1st 24 hrs. Nat. \_\_\_\_\_

1st 24 hrs. after shot \_\_\_\_\_

Gas \_\_\_\_\_ Cu. Ft.

Dry Hole \_\_\_\_\_

Abandoned \_\_\_\_\_

Date

AUG 8 1928

CHAS. L. SHERWOOD

Scout

MAP NO. K11 KANSAS SEC. 4 TWP. 27 R. 6

WELL NO. P 11 Schager  
Rosenthal et al COMPANY

CONTRACTOR

COMPLETED

SECTION PLAT

			0

\_\_\_\_\_ FT. FROM N. LINE

990 FT. FROM S. LINE

990 FT. FROM E. LINE

\_\_\_\_\_ FT. FROM W. LINE

LOCATION \_\_\_\_\_

RIG UP \_\_\_\_\_

DRILLING AND REMARKS:

TL 2755

700 Bl.

RECORD

CASED 3 IN. \_\_\_\_\_ FT.

SAND 3145-3158

GAS \_\_\_\_\_

OIL \_\_\_\_\_

TOTAL DEPTH 3158

PRODUCTION

1ST 24 HRS. NAT. \_\_\_\_\_

1ST 24 HRS. AFTER SHOT \_\_\_\_\_

GAS \_\_\_\_\_ CU. FT.

DRY HOLE \_\_\_\_\_

ABANDONED \_\_\_\_\_

DATE  
OCT 3 1928

**CHAS. L. SHERWOOD**

192

SCOUT