


Section 34 Township 27 Range 5-E

Well No. #1, Reitz

Company Rex and Morris etal

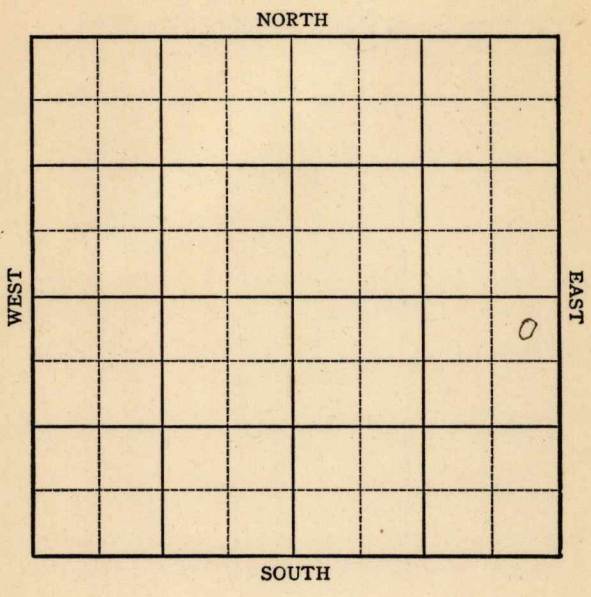

Sec. 34 Twp. 27 R. 5E

Well No. #1 Reitz Farm

Rex & Morris ETAL Company


Miscellaneous

330 Ft. from N. Line

Ft. from S. Line

330 Ft. from E. Line

Ft. from W. Line

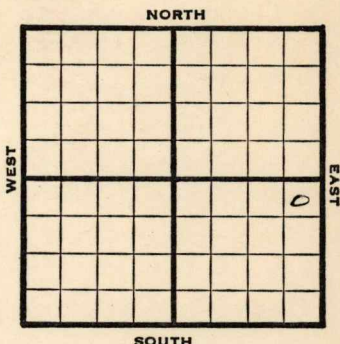

NE SE

1946 Elev. 1304' REPORT

- 9/25 Drilling 90'
- 10/1 13" @ 990'
- Drlg 1020'
- 10/8 10" @ 1550'
- Drlg 1790'
- 10/15 Lans 1810'
- KC 2130'
- Bart 2784
- Miss 2725, Drlg
- 10/22 8" @ 2270'
- Viola 3110'
- TD 3115'
- 7" @ 3110' WOC
- 10/30 Miss 2725'
- Viola 3110'
- 7" @ 3110'
- 1000 Acid
- Pump 20 POT
- TD 3115
- 38 Grav.

COMPLETED

KANSAS Kansas Pool Name MiscellaneousMap No. 11 Sec. 34 Twp. 27 R. 5EWell No. 1 ReitzRex & Morris Etal. CompanyFIRST REPORT Contractor

NE SE

SECTION PLAT

330 Ft. from N. Line

_____ Ft. from S. Line

330 Ft. from E. Line

_____ Ft. from W. Line

			o

Butler County

Location _____

Rig up _____

Drilling and Remarks:

90'

RECORD

Cased _____ in., _____ ft.

Sand _____

Gas _____

Oil _____

Total Depth _____

PRODUCTION

1st 24 hrs. Nat. _____

1st 24 hrs. after shot _____

Gas _____ Cu. Ft.

Dry Hole _____

Abandoned _____

Date

SEP 25 1946 19 _____S. J. LEWIS Scout

Map No. / / Sec. 34 Twp. 27 R. 5E

Well No. 1 Reitz

Rex & Morris etal. Company

COMPLETED

Contractor

NE SE

E 1, 1304

SECTION PLAT

330 Ft. from N. Line

 Ft. from S. Line

330 Ft. from E. Line

 Ft. from W. Line

			0

Butler County

RECORD

Location

Cased in., ft.

Rig up

Sand

Drilling and Remarks:

Gas

Oil

Total Depth 3115

PRODUCTION

1st 24 hrs Nat.

1st 24 hrs. after shot

Gas Cu. Ft.

Dry Hole

Abandoned

*Misc 2725
Vista 3110
7" @ 3110
1000 acid
Pump 20 BX
380/4*

Date

OCT 30 1946 19

S. J. LEWIS Scout