

Cowley


KANSAS

SECTION 24 TOWNSHIP 32 RANGE 4 E

WELL NO. #2 Detmer

COMPANY H. H. Blair

NORTH

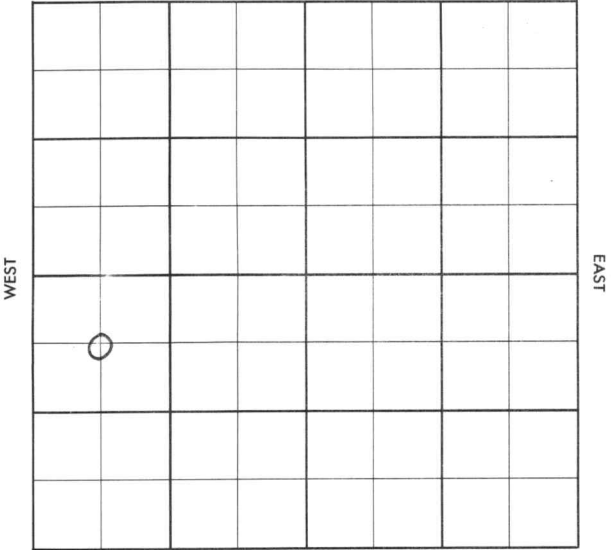

SOUTH

Cowley

KANSAS

SEC.	TWP.	R.
24	32	4E

WELL NO.

#2 Detmer

FARM

COMPANY

H.H. Blair

CONTRACTOR

Krisswell

Winfield

660

Ft. from N. Line


Ft. from S. Line

Ft. from E. Line

515

Ft. from W. Line

C NW SW

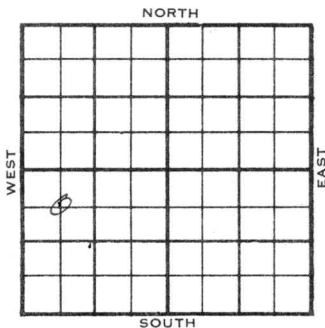

1956

ELEVATION

REPORT

1-11

MIR

2-1

Comm. 1-10-56

8 5/8" @ 90

5 1/2" @ 2969

CO to 2977

Frac,

Comp. 25 bopd

Stal. 1897

Layton 2333

KC 2506

Oswego 2654

Ce. 2773

Bart 2969

TD 2977

COMPLETED

TOPS	DEPTH	LOG	DATUM	Loc. in Sec.
Anh.				C NW SW
TP.				660' NL
H.				515' WL
Tr.				Geol.
Dg.				Contr.
BL.				Krisswell
L.				Pool
K.C.				Winfield
B.K.C.				FIRST REPORT JAN 11 '56
Ce.				
C.				
M.				
M.				
K.				
Mz.				
Mq.				
V.				
S.				
S.				
A				
R.				
PE.				
G.				
TD.				

MIR

不

County Cowley Elev. _____
 Sec. 24 Twp. 32 Rge. 4E
 Company H. H. Blair
 Farm Name Detmer No. 2

TOPS	DEPTH	LOG	DATUM	Loc. in Sec. _____
Anh.				C NW SW
Tp.				660' NL
H. <u>Stal</u>	<u>1897</u>			515' WL
Tr. <u>Sayton</u>	<u>2333</u>			
Dg.				
Bl.				
L.				Geol. _____
K.C.	<u>2506</u>			Contr. _____
B.K.C. <u>Oswego</u>	<u>2654</u>			Kriswell
Ce.	<u>2773</u>			
C. <u>Bart</u>	<u>2969</u>			Pool _____
M.				Winfield
M.				
K.				
Mz.				
Mo.				
V.				
S.				
S.				
A.				
R.				
Pe.				
G.				
T.D.	<u>2977</u>			

COMPLETE

Date Comm. 1-10-56

FEB 1 1956

8 5/8" @ 90 5 1/2" @ 2969 C⁰ to 2977

frac Comp. 25 bopd