

Map No. Kane Sec. 24 Twp. 32 R. 4


Well No. 2 Setmer Farm
Mc Knob Company

200 Ft. from N. Line

..... Ft. from S. Line

200 Ft. from E. Line

..... Ft. from W. Line

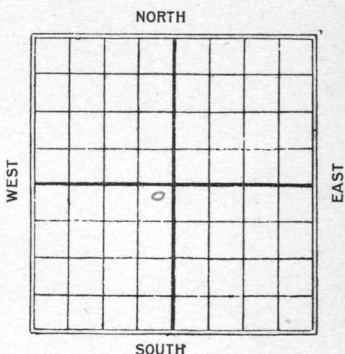

Date
1925

REPORT

1/24 S. + a. 1500' No sands

Map No. *2* ~~KANONG~~ Sec. *24* Twp. *32* R. *4*

Well No. *2 Lactmer*
M^o Knab. Company

This is also # 2 Contractor

**FIRST REPORT
ABANDONED**

SECTION PLAT

200 Ft. from N. Line
Ft. from S. Line
200 Ft. from E. Line
Ft. from W. Line

| | | | |
|--|--|--|--|
| | | | |
| | | | |
| | | | |
| | | | |

Location _____
Rig up _____
Drilling and Remarks:

*10+0,
1500' No sands
show on log.*

RECORD

Cased _____ in., _____ ft.
Sand _____
Gas _____
Oil _____
Total Depth _____

PRODUCTION

1st 24 hrs. Nat. _____
1st 24 hrs. after shot _____
Gas _____ Cu. Ft.
Dry Hole _____
Abandoned _____

Date
1/24 192*5*

M. A. BENEAR

Scout