

Map No. KANSAS Sec. 22 Twp. 32 R. 4E

Well No. 1 - Winfield Lste. Farm


Wakefield & Roth Company

200 Ft. from N. Line

..... Ft. from S. Line

375 Ft. from E. Line

..... Ft. from W. Line

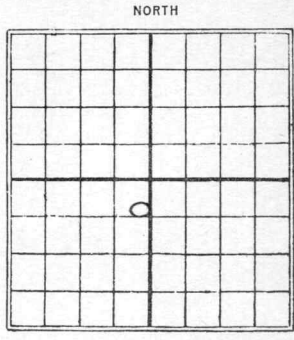

1927 Gen. East end Lot #1 Blk #41

Date REPORT Muskgrove Rdd.

| Date | Description |
|-------|--|
| 9/28 | Spudding 200' |
| 10/6 | Drly 1405. |
| 10/12 | " 1620 |
| 10/19 | " 2015 |
| 11/2 | Show oil & Gas at 2278-2310 Show oil 2340-64 T.D. 2517 800,000 gas |
| 1928 | O.W.D.D. |
| 2/9 | Burbank sand 2909-2917 T.D. 2917' 3 1/2 M gas |
| 1930 | OWDD |
| 10/11 | Old T.D. 2917 drly. 2969' |
| 10/8 | Sand 2909-58 Top chat 2958 TD 2963 1 1/2 M gas |

(Over)
OWDD

1931 OWDD

10/14 - Old TD. 2963

Rng 5" - 3285'

10/21 - Top Silic lime 3286

-HFW-

5" - 3287

TD. 3288 1/2

sw ab 75 bbl oil

10/28 - Silic lime 3286

TD. 3288 1/2

Pump 75 bbl oil
Comp.

1931

OWDD

11/10 - Old TD. 3288 1/2

Deepened to

T.D. 3296

Est 250 bbl oil

11/18 - TD. 3296' No test

11/24 Deepened to

T.D. 3296

Pump 300 bbl
Comp.

Cowley

2 KANSAS Map No. Sec. 27 Twp. 32 R. 4

Well No. 1 *Winfield Town Site*

Wakarusa & Koth Company

Contractor

FIRST REPORTS

SECTION PLAT

----- Ft. from N. Line

----- Ft. from S. Line

----- Ft. from E. Line

----- Ft. from W. Line

*Center East Camp lot 1
Block 41, Musgrove Adu*

| | | | |
|--|--|--|--|
| | | | |
| | | | |
| | | | |
| | | | |

Location -----

Rig up -----

Drilling and Remarks:

Spog 200'

RECORD

Cased ----- in., ----- ft.

Sand -----

Gas -----

Oil -----

Total Depth -----

PRODUCTION

1st 24 hrs. Nat. -----

1st 24 hrs. after shot -----

Gas ----- Cu. Ft.

Dry Hole -----

Abandoned -----

Date

SEP 23 1927

CHAS. L. SHERWOOD

192

Scout

Map No. 2 KANSAS Sec. 22 Twp. 32 R. 4

Well No. 1 Winfield Town site

Wassfield & Roth Company

Contractor

COMPLETED

SECTION PLAT

| | | | |
|--|--|--|--|
| | | | |
| | | | |
| | | | |
| | | | |
| | | | |

----- Ft. from N. Line

----- Ft. from S. Line

----- Ft. from E. Line

----- Ft. from W. Line

*Center east end hot 1
Blis 41, Musgrove addn*

Location -----

Rig up -----

Drilling and Remarks:

*Show oil @ 560
2278-2310*

Show oil 2340-64'

560 well

RECORD

Cased _____ in., _____ ft.

Sand 2499-2517

Gas -----

Oil -----

Total Depth 2517

PRODUCTION

1st 24 hrs. Nat. -----

1st 24 hrs. after shot -----

Gas 800,000 Cu. Ft.

Dry Hole -----

Abandoned -----

Date

NOV 2 - 1927

CHAS. L. SHERWOOD

Cowley

2 KANSAS

Map No. _____ Sec. *22* Twp. *32* R. *4*

Well No. *1* *Falcon etc*

Wade Field & Roth Company

Contractor _____

*Center East End lat 1
Bly 41, musgrove addn*

SECTION PLAT

| | | | |
|---------------|--|--|--|
| FIRST REPORTS | | | |
| COMPLETED | | | |
| | | | |
| | | | |
| | | | |

_____ Ft. from N. Line

_____ Ft. from S. Line

_____ Ft. from E. Line

_____ Ft. from W. Line

"old gas well killed, deepen"

Location _____ *Burbony*

Rig up _____

Drilling and Remarks:

*Was completed in
sand 2499-2517 jar
800,000 cu ft gas*

RECORD

Cased _____ in., _____ ft.

Sand *2909-2917'*

Gas _____

Oil _____

Total Depth *2917*

PRODUCTION

1st 24 hrs. Nat. _____

1st 24 hrs. after shot _____

Gas *3 1/2* *4* _____ Cu. Ft.

Dry Hole _____

Abandoned _____

Date

FEB 9 1928 CHAS. L. SHERWOOD

192

Scout

Cowley

2 KANSAS

Map No. Sec. *22* Twp. *32* R. *H* ^E

Well No. *1* *Winfield Jewnsite*

Wakefield & Roth Company

..... Contractor

FIRST REPORTS

SECTION PLAT

"old gas well deeper"

..... Ft. from N. Line

..... Ft. from S. Line

..... Ft. from E. Line

..... Ft. from W. Line

Center East end of hot 1- Blk H, Musgrove addit

| | | | |
|--|--|--|--|
| | | | |
| | | | |
| | | | |
| | | | |

Location

Rig up *20 was 2917'*

Drilling and Remarks:

Dry 2969'

RECORD

Cased..... in., ft.

Sand

Gas

Oil

Total Depth

PRODUCTION

1st 24 hrs. Nat.

1st 24 hrs. after shot

Gas..... Cu. Ft.

Dry Hole

Abandoned

Date

OCT 1 1930

192.....

CHAS. L. SHERWOOD

Scout

Cowley

Map No. _____ Sec. *22* Twp. *32* R. *4*

Well No. *1* *Winfield Don site*

Waverfield *Boths* Company

Contractor

COMPLETE

_____ Ft. from N. Line

_____ Ft. from S. Line

_____ Ft. from E. Line

_____ Ft. from W. Line

Center East end of

lot 1, Blk 41, Musgrove addn

SECTION PLAT

| | | | |
|--------------|----------|--|--|
| <i>11</i> | | | |
| <i>Quads</i> | | | |
| | <i>0</i> | | |
| | | | |

Location _____

Rig up _____

Drilling and Remarks:

Jap Chat 2958

RECORD

Cased _____ in., _____ ft.

Sand *2909-2958*

Gas _____

Oil _____

Total Depth *2963*

PRODUCTION

1st 24 hrs. Nat. _____

1st 24 hrs. after shot _____

Gas *1 1/2 M* Cu. Ft.

Dry Hole _____

Abandoned _____

Date

OCT 8 1930

192

CHAS. L. SHERWOOD

Scout

Cowley

E

Map No. KANSAS Sec. 22 Twp. 32 R. 4

Well No. 1 *Winfield Town site*

Wadefield Oil Company

Contractor

FIRST REPORTS

SECTION PLAT

200 Ft. from N. Line

..... Ft. from S. Line

375 Ft. from E. Line

..... Ft. from W. Line

"*OWD*"

| | | | |
|----------------|-----------------|--------------|---------------|
| <i>Center</i> | <i>East</i> | <i>End</i> | <i>hot 1.</i> |
| <i>Blk 41.</i> | <i>Musgrove</i> | <i>addn.</i> | |
| | <i>o</i> | | |
| | | | |
| | | | |

Location.....

Rig up.....

Drilling and Remarks:

old Sand record
2907-17-3 1/2 M.

ring 5" 3785

RECORD

Cased.....in.,ft.

Sand.....

Gas.....

Oil.....

Total Depth.....

PRODUCTION

1st 24 hrs. Nat.....

1st 24 hrs. after shot.....

Gas.....Cu. Ft.

Dry Hole.....

Abandoned.....

Date

OCT 14 1931

CHAS. L. SHERWOOD

192

Scout

Cowley

Map No. 2 KANSAS Sec. 22 Twp. 32 R. 4 ^E

Well No. 1 *Wingfield Town site*

Wingfield & Roth Company

Contractor

COMPLETED

SECTION PLAT

200 Ft. from N. Line
Ft. from S. Line
375 Ft. from E. Line
Ft. from W. Line

| | | | |
|--|---|--|--|
| | | | |
| | | | |
| | 0 | | |
| | | | |

Location.....

Rig up.....

Drilling and Remarks:

Pump 75 Bl.

RECORD

Cased..... in., ft.

Sand *Siliceous 3286-88 1/2*

Gas.....

Oil.....

Total Depth 3288 1/2

PRODUCTION

1st 24 hrs. Nat.....

1st 24 hrs. after shot.....

Gas..... Cu. Ft.

Dry Hole.....

Abandoned.....

Date

OCT 23 1931

CHAS. L. SHERWOOD

192

Scout

Cowley

Map No. KANSAS Sec. 22 Twp. 32 R. 4^{1E}

Well No. 1 *Wingfield Townsite*

Wakefield & Roth Company

Contractor

FIRST REPORTS

700 Ft. from N. Line

..... Ft. from S. Line

375 Ft. from E. Line

..... Ft. from W. Line

Center East End lot 1

Blk 41, Musgrove Addn

Location.....

Rig up.....

Drilling and Remarks:


Deepened to 3296'

Est 250 Bls.

Date

NOV 10 1931

SECTION PLAT

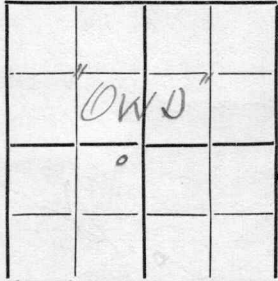

RECORD

Cased.....in.,ft.

Sand.....

Gas.....

Oil.....

OK Total Depth 3288 1/2

PRODUCTION

1st 24 hrs. Nat.....

1st 24 hrs. after shot.....

Gas.....Cu. Ft.

Dry Hole.....

Abandoned.....

2 *Cowley*
Map No. *KANSAS* Sec. *22* Twp. *32* R. *4* ^E

Well No. *1* *Winfield Inside*

Wade field & Rath Company

Contractor

COMPLETED

SECTION PLAT

200 Ft. from N. Line

..... Ft. from S. Line

375 Ft. from E. Line

..... Ft. from W. Line

@ East end hot 1

| | | | |
|--|--|------------|--|
| | | | |
| | | | |
| | | <i>OWD</i> | |
| | | <i>o</i> | |
| | | | |
| | | | |

Blk 41 - Musgrove adew

Location.....

Rig up.....

Drilling and Remarks:

Pump 300 Bls.

RECORD

Cased *11* in., ft.

Sand *Deepener to 329.6*

Gas.....

Oil.....

Total Depth *329.6*

PRODUCTION

1st 24 hrs. Nat.....

1st 24 hrs. after shot.....

Gas..... Cu. Ft.

Dry Hole.....

Abandoned.....

Date

NOV 24 1931

CHAS. L. SHERWOOD