


Butler

Map No. *Kansas* Sec. *4* Twp. *27* R. *6*

Well No. *6 Schaffer* Farm

Rosenthal & Lassen Company

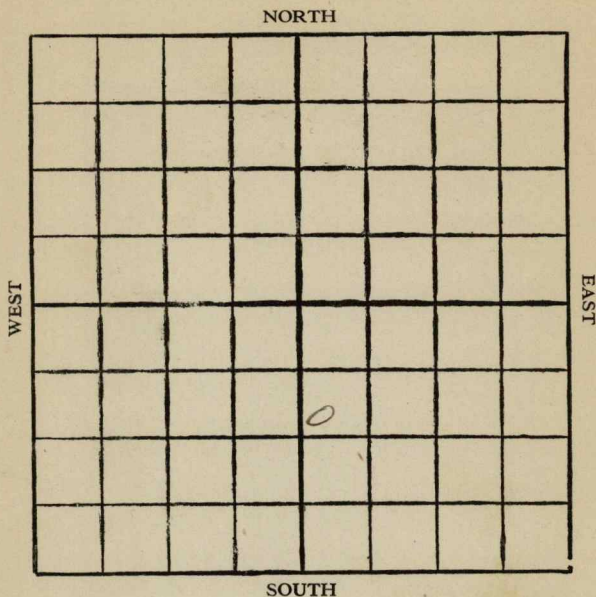

Location

Drilling Remarks

.....

.....

RECORD

Cased in. ft.

Sand

Gas

Oil

Total Depth

Rig Up

Drilling Remarks

.....

.....

PRODUCTION

1st 24 hrs. Nat.

1st 24 hrs. after shot

Gas cu. ft.


Dry Hole

Abandoned

Butler

Map No. Kansas Sec. 4 Twp. 27 R. 6Well No. 6 Schaffer Farm
Rosenthal & Lassin Company

NORTH

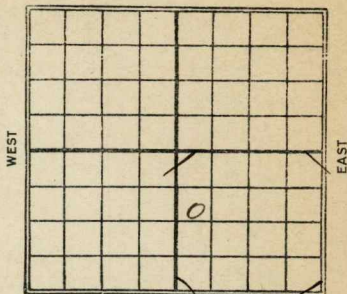

WEST

EAST

SOUTH

990 Ft. from N. Line

Ft. from S. Line

Ft. from E. Line

320 Ft. from W. LineDate
1927

REPORT

5/18 Rig up5/25 Rlg6/1 —6/7 Rig up6/15 Spudding6/22 Drlg 5006/29 " 13007/7 " 18757/13 " 24007/20 Top line 2778 - Show oil7/28 + H.F.W. - Drlg 2950-8/3 Setting 5" - 3120-Top line 27783154 - 3161240 bblsT.D. 3161'


11 **KANSAS** *Butter*
 Map No. _____ Sec. *4* Twp. *27* R. *6*
 Well No. *6 Schaffer*
Bozenthall & Lussen Company

Contractor

FIRST REPORTS*990* Ft. from N. Line

_____ Ft. from S. Line

_____ Ft. from E. Line

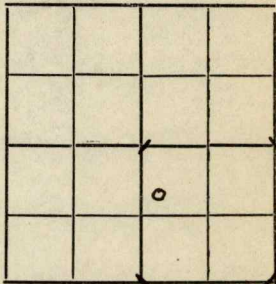330 Ft. from W. Line**SECTION PLAT**

Location _____

Rig up ☒ _____

Drilling and Remarks:

RECORD

Cased _____ in., _____ ft.

Sand _____

Gas _____

Oil _____

Total Depth _____

PRODUCTION

1st 24 hrs. Nat. _____

1st 24 hrs. after shot _____

Gas _____ Cu. Ft.

Dry Hole _____

Abandoned _____

Date

MAY 18 1927 CHAS. L. SHERWOOD
 _____ 192 _____ Scout

Map No. **KANSAS** Sec. 4 Twp. 27 R. 6

Well No. 6 Schaper
Rosenthal & Hassen Company

Contractor

COMPLETED

SECTION PLAT

		0	

990 Ft. from N. Line

_____ Ft. from S. Line

_____ Ft. from E. Line

330 Ft. from W. Line

Location _____

Rig up _____

Drilling and Remarks:

Top lens 2778-

240 lbs.

RECORD

Cased _____ in., _____ ft.

Sand 3154-3161

Gas _____

Oil _____

Total Depth 3161

PRODUCTION

1st 24 hrs. Nat. _____

1st 24 hrs. after shot _____

Gas _____ Cu. Ft.

Dry Hole _____

Abandoned _____

Date

AUG

3 1927

192

CHAS. L. SHERWOOD

Scout