

WEST

EAST

SOUTH

Drilling Remarks


Drilling Remarks

Total Depth

Abandoned

KANSASMap No. _____ Sec. 4 Twp. 27 R. 6Well No. 9-Schafer Farm _____Rosenthal et al Company _____

NORTH

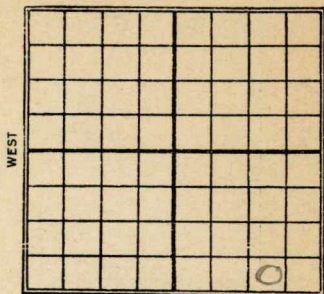

_____ Ft. from N. Line

330 Ft. from S. Line990 Ft. from E. Line

_____ Ft. from W. Line

SOUTH

1927

Date

REPORT

12/21	Rig up
12/29	Rigging up-
1928	
1/5	—
1/11	Drilg 680'
1/18	" 1600
1/26	" 2200
2/2	Top line 2780 - drilg 2825-
2/9	Setting 5" - 3095-
2/15	3133-3141 T.D 3141
	Top line 2780-3067
	150 bbls

Butter
 11 KANSAS
 Map No. _____ Sec. 4 Twp. 27 R. 6
 Well No. 9 Schaper
 Rodenthal et al
 _____ Company

 Contractor

FIRST REPORTS

SECTION PLAT

 Ft. from N. Line

330

 Ft. from S. Line

990

 Ft. from E. Line

 Ft. from W. Line

			o

Location _____

Rig up _____ ✓

Drilling and Remarks:

RECORD

Cased _____ in., _____ ft.

Sand _____

Gas _____

Oil _____

Total Depth _____

PRODUCTION

1st 24 hrs. Nat. _____

1st 24 hrs. after shot _____

Gas _____ Cu. Ft.

Dry Hole _____

Abandoned _____

Date

DEC 21 1927

192

CHAS. L. SHERWOOD

Scout

Butler

 11 **KANSAS** Map No. _____ Sec. 4 Twp. 27 R. 6^E

 Well No. 9 Schaper
Rosenthal et al Company

Contractor

COMPLETED**SECTION PLAT**

_____ Ft. from N. Line

330 Ft. from S. Line990 Ft. from E. Line

_____ Ft. from W. Line

			o

Location _____

Rig up _____

Drilling and Remarks:

Top line 2780-3067150 fbs.**RECORD**

Cased _____ in. _____ ft.

Sand 3133-3141'

Gas _____

Oil _____

Total Depth 3141'**PRODUCTION**

1st 24 hrs. Nat. _____

1st 24 hrs. after shot _____

Gas _____ Cu. Ft.

Dry Hole _____

Abandoned _____

Date

FEB 15 1928

192

CHAS. L. SHERWOOD

Scout