


Map No. Kansas Sec. 24 Twp. 32 R. 4^E
 Well No. 1 Setmer Farm
Mc Knab Company

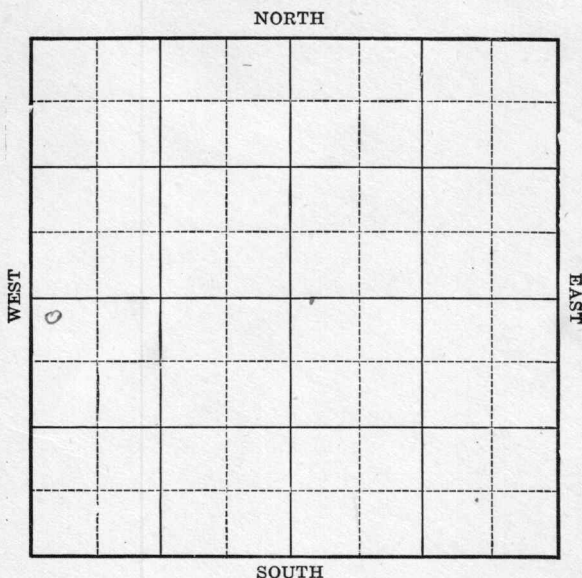

Location _____

Drilling Remarks _____

RECORD

Cased _____ in. _____ ft.

Sand _____

Gas _____

Oil _____

Total Depth _____

Rig Up _____

Drilling Remarks _____

PRODUCTION

1st 24 hrs. Nat. _____

1st. 24 hrs. after shot _____

Gas _____ cu. ft.


Dry Hole _____

Abandoned _____

Map No. Kans Sec. 24 Twp. 32 R. 4^EWell No. 1 Setmer Farm
Mc Knab Company200 Ft. from N. Line

_____ Ft. from S. Line

_____ Ft. from E. Line

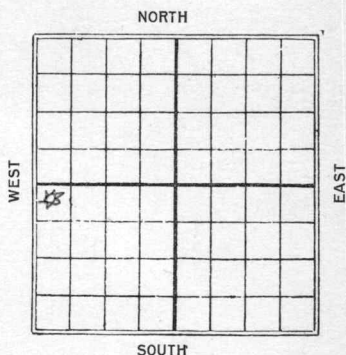200 Ft. from W. Line1st & CompDate
1925

REPORT

1/24 Gas Sand 650-670 Est
150 Bbls 1/4 m Gas
now Plugged & abandoned

Map No. 24 Sec. 32 Twp. 4E

Well No. 1 Letmer

Mc Knab Company

Contractor

FIRST REPORT ABANDONED

SECTION PLAT

200 Ft. from N. Line

_____ Ft. from S. Line

_____ Ft. from E. Line

200' Ft. from W. Line

Location _____

Rig up _____

Drilling and Remarks:

*Gas sand, 650-670
est 150-200 thousand
gas.*

*Now plugged
& abandoned.*

RECORD

Cased _____ in., _____ ft.

Sand _____

Gas _____

Oil _____

Total Depth _____

PRODUCTION

1st 24 hrs. Nat. _____

1st 24 hrs. after shot _____

Gas _____ Cu. Ft.

Dry Hole _____

Abandoned _____

Date

M. A. BENEAR

1/24 1925 Scout