


Map No. Kansas Sec. 24 Twp. 32 R. 4^E
 Well No. 4 Sennott (Detmer) Farm
J. A. Hull Company

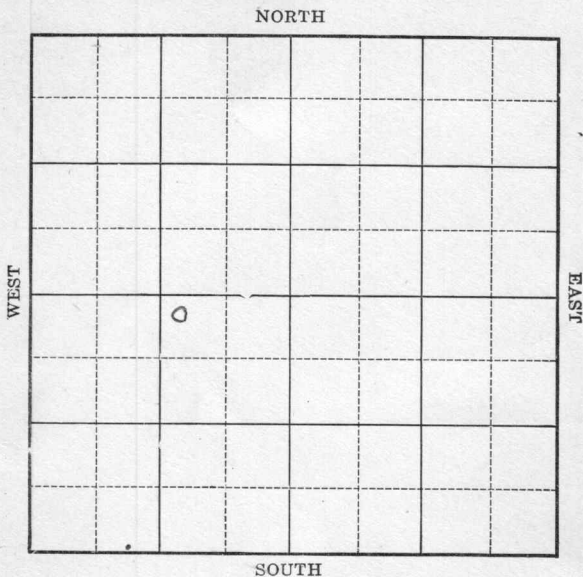

Location _____

Drilling Remarks

RECORD

Cased _____ in. _____ ft.

Sand _____

Gas _____

Oil _____

Total Depth _____

Rig Up _____

Drilling Remarks

PRODUCTION

1st 24 hrs. Nat. _____

1st 24 hrs. after shot _____

Gas _____ cu. ft.

Dry Hole _____


Abandoned _____

Map No. K Sec. 24 Twp. 32 R. 4^EWell No. 4 Senmore Farm
J. A. Hull Company200 Ft. from N. Line

Ft. from S. Line

1120 Ft. from E. Line

Ft. from W. Line

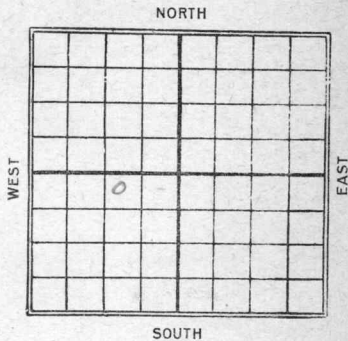

Date

REPORT

192411/6 R. O. G.11/26 Rgn up12/17 Dlg. 1215'19251/21 Dlg 21353/1 Oil 2988-3021T.D. 3030160 qt 200 bbls

9/15/25 6/24/25

Map No. **KANSAS** Sec. **24** Twp. **32** R. **4**Well No. **4 L. Outmore**

J. A. Kull Company

1st Contractor**COMPLETED**

SECTION PLAT

	0		

200 Ft. from N. Line

Ft. from S. Line

1120 Ft. from E. Line

Ft. from W. Line

Location

Rig up

Drilling and Remarks:

Oil 2988-3021

T.D. 3030'

160/200 lbs.

no change

OK now Jan

RECORD

Cased in, ft.

Sand

Gas

Oil

Total Depth

PRODUCTION

1st 24 hrs. Nat.

1st 24 hrs. after shot

Gas Cu. Ft.

Dry Hole

Abandoned

Date

M. A. BENEAR

1925

Scout

Beneas -

Maps show a number
4 producing well on
this eighty acres located
660 ft. from north line
+ 200 ft. from East line -

Please advise -

Beneas our maps show
a number 4 well on this
40 acres. There are 2 well
number 4 here.

Returned *Geo*

Cards *B*

Tracing

J. S. C. map

East map *on*

Moody map

East plat book

Moody plat book