

KANSAS

Form 51—5M—7-39—Palace

Butler

Section 35 Township 27 Range 5-E

Well No. #1 Reetz

Company Cromwell & Lewis

NORTH

Wildcat

WEST

EAST

0							

SOUTH

KANSAS

Butler

Sec. 35 Twp. 27 R. 5-EWell No. #1 Reetz FarmCromwell & Lewis

Company

(Wildcat)

Ft. from N. Line


330

Ft. from S. Line

Ft. from E. Line

330

Ft. from W. Line

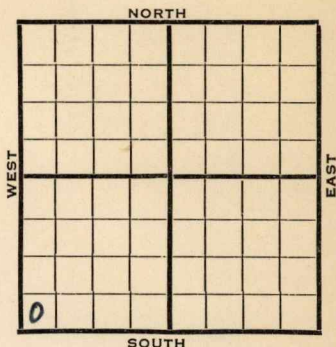

Elev. 1284

1940

REPORT

6/12

Cellar.

6/20

Machine.

6/27

12" - 15'

Drlg. 900'

7/3

8" - 1290' Drlg. 1520'

7/11

10" - 1290' 8" - 2180'

Drlg. 2185'

7/18

6" - 2697' WOC.

7/25

Drlg. 3000'

7/31

Arbuckle 3130'

T.D. 3135'

ABANDONED

Map No. 11 Sec. 35 Twp. 27 R. 5EWell No. 1 ReetzCromwell & Lewis Company

Contractor

FIRST REPORT

SECTION PLAT

SW/C

Ft. from N. Line

330

Ft. from S. Line

Ft. from E. Line

330

Ft. from W. Line

WILDCAT

Location _____

Rig up _____

Drilling and Remarks:

Cellar

RECORD

Cased _____ in., _____ ft.

Sand _____

Gas _____

Oil _____

Total Depth _____

PRODUCTION

1st 24 hrs. Nat. _____

1st 24 hrs. after shot _____

Gas _____ Cu. Ft.

Dry Hole _____

Abandoned _____

Date

JUN 12 1940

19

S. J. LEWIS Scout

Map No. // Sec. 35 Twp. 27 R. 5EWell No. 1 ReetzCrowell & Lewis

Company

Contractor

ABANDONED

SECTION PLAT

SW/C

 Ft. from N. Line330 Ft. from S. Line Ft. from E. Line330 Ft. from W. Line

o			

WILDCAT

Location Rig up

Drilling and Remarks:

D + A

RECORD

Cased in. ft.Sand 3130Gas Oil Total Depth 3135

PRODUCTION

1st 24 hrs. Nat. 1st 24 hrs. after shot Gas Cu. Ft.Dry Hole Abandoned

Date

JUL 31 1940 19

S. J. LEWIS

Scout