

KANSAS

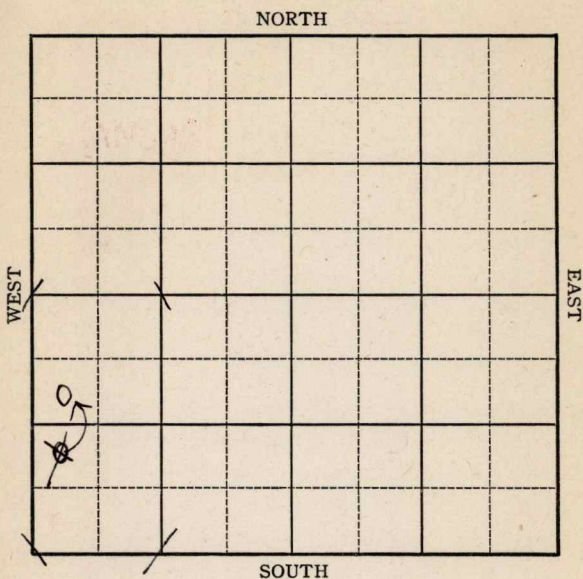
Bulter

FORM 51 5M 1-42 PETROL

Section 35 Township 27 Range 5-E

Well No. #1 Reetz & Skaer

Company Cromwell & Lewis



Sec. 35 Twp. 27 R. 5-E

Well No. #1 Reetz & Skaer Farm
Cromwell & Lewis Company

Miscellaneous

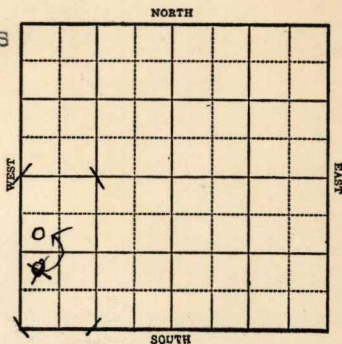
990 Ft. from N. Line

~~990~~ Ft. from S. Line

Ft. from E. Line

330 Ft. from W. Line

Elev. 1296



1943

R E P O R T

3/3	Cable.
3/10	"
3/17	"
3/24	Drlg. 240'
3/31	Drlg. 1085
4/7	10" @ 1321'
	Drlg. 1715'
4/14	8" @ 2215'
	Drlg. 2230'
4/21	6" @ 2670'
	Drlg. 2710'
4/28	Bart 2686
	Miss 2714
	6" @ 2723
	Drlg. 2930'
5/5	B. Miss 3014
	T.D. 3090
	Drlg. 1050'

OVER

1943

5/12 Viola 3097

T.D. 3100 So

5" @ 3097 Rust.

5/19 T. D. 3101-400' oil 4 hrs
1000 acid

5/26 Viola 3097

5" @ 3097'

T.D. 3101'

1000 gal acid

Pump 15 Pot.

Gravity 37.4

COMPLETED

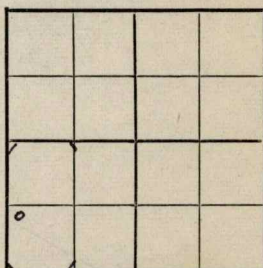
Butler

KANSAS

Map No. Sec. 35 Twp. 27 R. 5EWell No. 1 Reetz & SkaerCronwell & Lewis CompanyFIRST REPORT Contractor

NW SW SW

SECTION PLAT

 Ft. from N. Line990 Ft. from S. Line Ft. from E. Line330 Ft. from W. Line

MISCELLANEOUS

RECORD

Location Cased in., ft.Rig up Sand

Drilling and Remarks:

Gas

Cable

Oil Total Depth

PRODUCTION

1st 24 hrs. Nat. 1st 24 hrs. after shot Gas Cu. Ft.Dry Hole Abandoned

Date

MAR 3 1943 19

S. J. LEWIS Scout

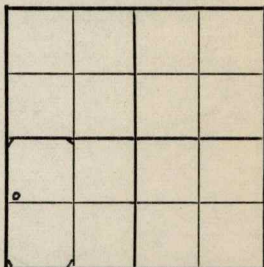
KANSAS

Butler

Map No. 11 Sec. 35 Twp. 27 R. 5EWell No. 1 Reetz & SkaerCromwell & Lewis CompanyCORRECTION Contractor

SW NW SW

SECTION PLAT

990 Ft. from N. Line Ft. from S. Line Ft. from E. Line330 Ft. from W. Line

MISCELLANEOUS

Location Rig up

Drilling and Remarks:

Reported

NW SW SW

RECORD

Cased in., ft.Sand Gas Oil Total Depth

PRODUCTION

1st 24 hrs. Nat. 1st 24 hrs. after shot Gas Cu. Ft.Dry Hole Abandoned

Date

MAR 17 1943

19

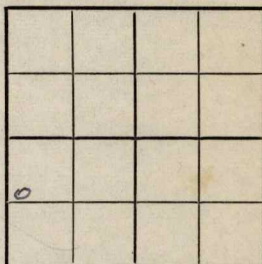
S. J. LEWIS

Scout

KANSASMap No. Sec. 35 Twp. 27 R. 5EWell No. 1 Reetz & SkaerCromwell & Lewis CompanyCOMPLETED Contractor

SW NW SW

SECTION PLAT

990 Ft. from N. Line Ft. from S. Line Ft. from E. Line330 Ft. from W. Line

MISCELLANEOUS

Location Rig up

Drilling and Remarks:

*Viola 3097**5" @ 3097**1000 Gall**Pump 15 Pst.**374 Gr*

RECORD

Cased in., ft.Sand Gas Oil Total Depth 8101

PRODUCTION

1st 24 hrs. Nat. 1st 24 hrs. after shot Gas Cu. Ft.Dry Hole Abandoned

Date

MAY 26 1943 19S. J. LEWIS Scout