


Map No. Kan Sec. 24 Twp. 32 R. 4

Well No. 8 Detmer Farm \_\_\_\_\_  
J.A. Hull Company \_\_\_\_\_

NORTH

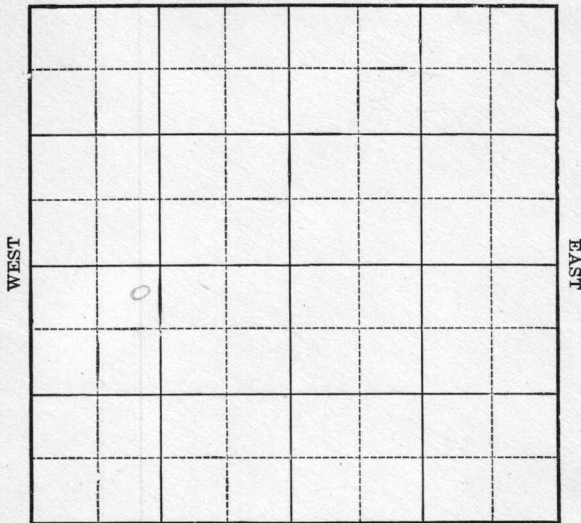

SOUTH

Location \_\_\_\_\_  
Drilling Remarks \_\_\_\_\_

Rig Up \_\_\_\_\_  
Drilling Remarks \_\_\_\_\_

\_\_\_\_\_

\_\_\_\_\_

**RECORD**

Cased \_\_\_\_\_ in. \_\_\_\_\_ ft.

Sand \_\_\_\_\_

Gas \_\_\_\_\_

Oil \_\_\_\_\_

Total Depth \_\_\_\_\_

**PRODUCTION**

1st 24 hrs. Nat. \_\_\_\_\_

1st. 24 hrs. after shot \_\_\_\_\_

Gas \_\_\_\_\_ cu. ft.

Dry Hole \_\_\_\_\_

Abandoned \_\_\_\_\_

Map No. *Kan* Sec. *24* Twp. *32* R. *4*


Well No. *P Detmer* Farm  
*J. A. Hull* Company

*300* Ft. from N. Line

\_\_\_\_\_ Ft. from S. Line

\_\_\_\_\_ Ft. from E. Line

*1020* Ft. from W. Line

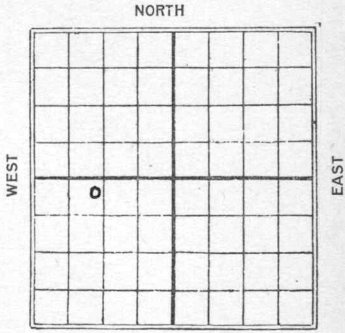

*50 ft. east of # 7* SOUTH *C*

Date

*1925*

REPORT

*7/3 Bldg rig*

*7/10 Rign up*

*7/17 345'*

*7/24 1200'*

*7/31 0/1 8" 1775'*

*8/7 2225'*

*8/14 sand 2323-49 J.D,  
100/75' bbls*

Map No. 2 Kando Sec. 24 Twp. 32 R. H

Well No. 8 Setmer

J. A. Hull Company

Contractor

### FIRST REPORTS

### SECTION PLAT

300 Ft. from N. Line

----- Ft. from S. Line

----- Ft. from E. Line

1020 Ft. from W. Line


50 feet East of #7.

Location -----

Rig up Flag -----

Drilling and Remarks:

### RECORD

Cased ----- in., ----- ft.

Sand -----

Gas -----

Oil -----

Total Depth -----

### PRODUCTION

1st 24 hrs. Nat. -----

1st 24 hrs. after shot -----

Gas ----- Cu. Ft.

Dry Hole -----

Abandoned -----

Date

JUL 3 1925

**CHAS. L. SHERWOOD**

Cowley Co

Map No. 2 KANSAS Sec. 24 Twp. 33 R. 4

Well No. 8 Settner

J. W. Hull

Company

Contractor

COMPLETED

SECTION PLAT

300 Ft. from N. Line

----- Ft. from S. Line

----- Ft. from E. Line

1020 Ft. from W. Line

50 E of #7.

o			

Location -----

Rig up -----

Drilling and Remarks:

100y  
75 bks.

RECORD

Cased ----- in., ----- ft.

Sand 2323 H9

Gas -----

Oil -----

Total Depth 2349'

PRODUCTION

1st 24 hrs. Nat. -----

1st 24 hrs. after shot -----

Gas ----- Cu. Ft.

Dry Hole -----

Abandoned -----

Date

AUG 14 1925

192

CHAS. L. SHERWOOD

Scout