
Form 51—5M—3-26—22544

Map No. KANSAS Sec. 24 Twp. 32 R. 4

Well No 1—Leitzner Farm

J. A. Hull Company

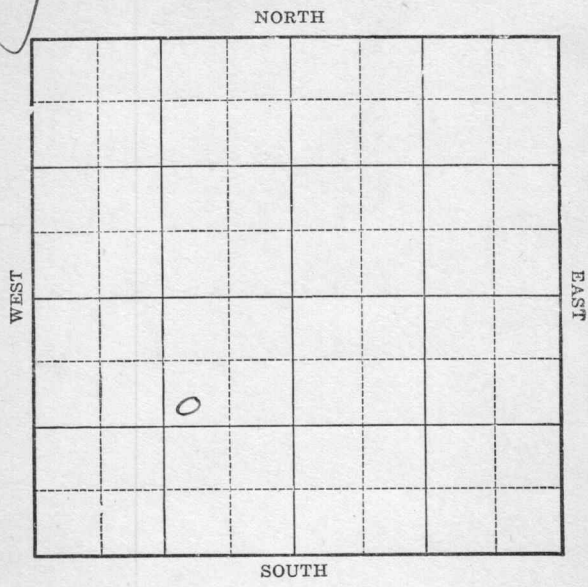

Location

Drilling Remarks

Rig Up

Drilling Remarks

RECORD

Cased in. ft.

Sand

Gas

Oil

Total Depth

PRODUCTION

1st 24 hrs. Nat.

1st 24 hrs. after shot

Gas cu. ft.

Dry Hole

Abandoned

Form 252A—5M—4-27—27425

KANSAS

Map No. ____ Sec. 24 Twp. 32 R. 4

Well No. 11 - Setmer Farm


J. A. Hull Company

1070 Ft. from N. Line

____ Ft. from S. Line

1070 Ft. from E. Line

____ Ft. from W. Line

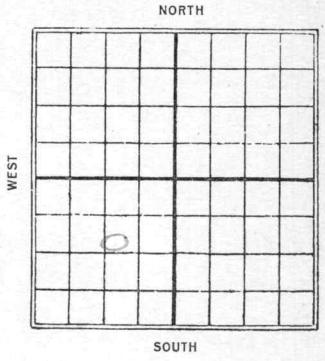

1927

Date	REPORT
12/29	Rig up
1928	
1/5	Rig
1/11	Drlg 430
1/18	" 1260
1/24	W.R. 10" - 1730.
2/2	Setting 8" - 2125
2/9	Setting 6" - 2603.
2/16	Drilling 2979 -
2/23	2970 - 3038 T.D. 3043
	140 B/O 100 bbls

Form 26—1M Bks.—3-23—11959.

Cowley

2 KANSAS 24 3r 4

Map No. ---------- Sec. ---------- Twp. ---------- R. ----------

Well No. 11 Detmer

J. G. Hull ---------- Company

---------- Contractor

FIRST REPORTS


1070 Ft. from N. Line

---------- Ft. from S. Line

1070 Ft. from E. Line

---------- Ft. from W. Line

SECTION PLAT

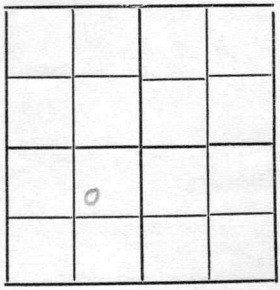

Location ----------

Rig up ----------

Drilling and Remarks:

RECORD

Cased ---------- in., ---------- ft.

Sand ----------

Gas ----------

Oil ----------

Total Depth ----------

PRODUCTION

1st 24 hrs. Nat. ----------

1st 24 hrs. after shot ----------

Gas ---------- Cu. Ft.

Dry Hole ----------

Abandoned ----------

Date

DEC 29 1927

---------- 192 ----

CHAS. L. SHERWOOD

---------- Scout

Form 26—1M Bks.—3-23—11959. Cowley

2 KANSAS

Map No. _____ Sec. 24 Twp. 32 R. 4

Well No. 11 Detmer

J. G. Auld Company

_____ Contractor

COMPLETED


1070 Ft. from N. Line

_____ Ft. from S. Line

1070 Ft. from E. Line

_____ Ft. from W. Line

SECTION PLAT

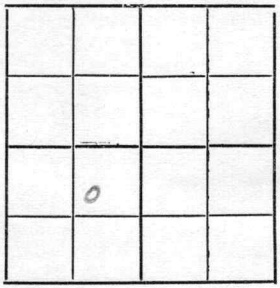

Location _____

Rig up _____

Drilling and Remarks:

140/100 Bls.

RECORD

Cased _____ in., _____ ft.

Sand 2970-3038

Gas _____

Oil _____

Total Depth 3043

PRODUCTION

1st 24 hrs. Nat. _____

1st 24 hrs. after shot _____

Gas _____ Cu. Ft.

Dry Hole _____

Abandoned _____

Date

FEB 23 1928

192

CHAS. L. SHERWOOD

Scout