


Section 24 Township 32 Range 4E **KANSAS**

Well Number 12 Detmer

Company Sinclair Prairie

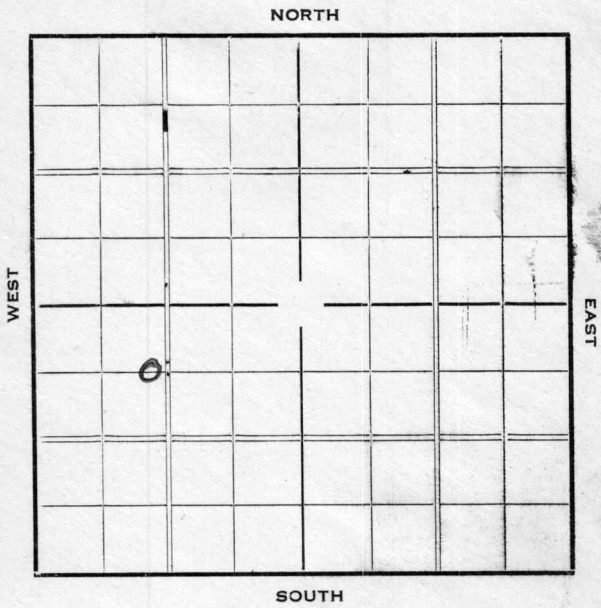

Cowley

KANSAS

Sec. 24 Twp. 32 R. 4-E

Well No. 12 Detmer Farm


Sinclair-Prairie Company

660 Ft. from N. Line

_____ Ft. from S. Line

_____ Ft. from E. Line

1100 Ft. from W. Line

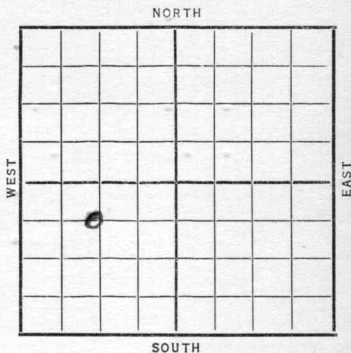

19 <u>36</u>	REPORT
11/10	Location
11/19	R O G
11/27	---
12/3	Rig
12/10	Rigging up.
12/17	15" @ 378'.
12/24	12" @ 885'. Drlg. 1192'.
12/29	10" @ 1581'. Drlg. 1600'.
1937	
1/7	Drlg. 2030'.
1/14	Drlg. 2540'.
1/21	8" @ 2130'. Show oil 2328'. 1 B W 2345'. 7" @ 2950' RUST.
1/28	Base Bart. Sand 3025'. T. D. 3032'. P.B. 3025'. Shot 120 qts. Swabbed 9 bbls in 24 hrs.
2/4	Shot 80 qts. Pull big pipe.
	OVER

1937

2/10 Bart. Sand 2950'.

Mississippi Lime 3025'.

T. D. 3032'.

P.B. 3025'.

Shot 120 qts.

Pump 25 bbls.

COMPLETED

Map No. 2 Sec. 24 Twp. 82 R. 4E

Well No. 12 Detmer

Sinclair-Prairie Company

Contractor

SECTION PLAT

660 Ft. from N. Line

_____ Ft. from S. Line

_____ Ft. from E. Line

1100 Ft. from W. Line

o			

FIRST REPORT

Location ✓

Rig up _____

Drilling and Remarks:

RECORD

Cased _____ in., _____ ft.

Sand _____

Gas _____

Oil _____

Total Depth _____

PRODUCTION

1st 24 hrs. Nat. _____

1st 24 hrs. after shot _____

Gas _____ Cu. Ft.

Dry Hole _____

Abandoned _____

Date

NOV 10 1936₁₉

S. J. LEWIS Scout

Map No. J 2 Sec. 24 Twp. 32 R. 4E

Well No. 12 Titmer

Sinclair Prairie Company

Contractor

SECTION PLAT

660 Ft. from N. Line

_____ Ft. from S. Line

_____ Ft. from E. Line

1100 Ft. from W. Line

0			

COMPLETED

Location _____

Rig up _____

Drilling and Remarks:

Bar t. Sand
2950
Mississippi L 3025
P. B 3025
Shot 1209 lb.
Pump 25 88 lb.

RECORD

Cased _____ in., _____ ft.

Sand _____

Gas _____

Oil _____

Total Depth 3032

PRODUCTION

1st 24 hrs. Nat. _____

1st 24 hrs. after shot _____

Gas _____ Cu. Ft.

Dry Hole _____

Abandoned _____

Date

FEB 10 1937 19

S. J. LEWIS Scout