

KANSAS


FORM 51 5M BRIX

Butler

Section 35 Township 27 Range 5E

Well No. #2 Weaver

Company Crom well - Lewis

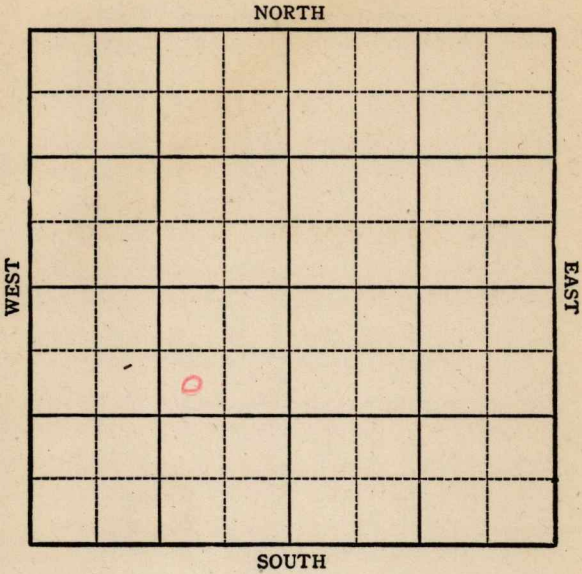

Sec. 35 Twp. 27 R. 5E

Well No. #2 Weaver Farm

Cromwell-Lewis Company


Miscellaneous

990 Ft. from N. Line

_____ Ft. from S. Line

990 Ft. from E. Line

_____ Ft. from W. Line

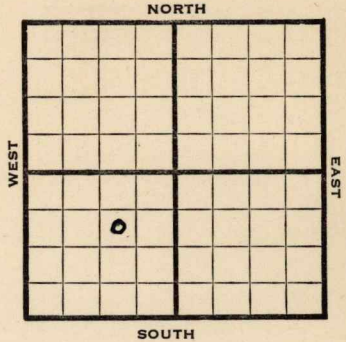

SW NE SW

1944

REPORT

8/9 12" - 332'
 10" - 1839'
KC 2145 SD

8/16 2385 fsg.
 8/23 Drlg. 2625
 8/30 **Bart. 2708**
 6" @ 2675
 Drlg. 2715 SO
 TD 2720

9/8
 9-13 **Bart 2708**
 6" @ 2675
 Pump 14 Pot.
 36.0 Gr.
 TD 2720

COMPLETED

KANSAS

Pool Name Miscellaneous

Map No. 11 Sec. 35 Twp. 27 R. 5E

Well No. 2 Weaver

Cromwell-Lewis Company

FIRST REPORT

Contractor

SW NE SW

SECTION PLAT

990 Ft. from N. Line

_____ Ft. from S. Line

990 Ft. from E. Line

_____ Ft. from W. Line

	0		

Butler County

Location _____

Rig up _____

Drilling and Remarks:

12" - 332

10" - 1839

KC 2145 SD

RECORD

Cased _____ in., _____ ft.

Sand _____

Gas _____

Oil _____

Total Depth _____

PRODUCTION

1st 24 hrs. Nat. _____

1st 24 hrs. after shot _____

Gas _____ Cu. Ft.

Dry Hole _____

Abandoned _____

Date

AUG 9 1944

19

S. J. LEWIS

Scout

Pool Name Miscellaneous

Map No. 11 Sec. 35 Twp. 27 R. 5E

Well No. 2 Weaver

Cromwell-Lewis Company

COMPLETED

Contractor

SW NE SW

SECTION PLAT

990 Ft. from N. Line

_____ Ft. from S. Line

990 Ft. from E. Line

_____ Ft. from W. Line

Butler County

Location _____

Rig up _____

Drilling and Remarks:

Part
Bar 42708

6" C 2675

Pump 14 P.D.

36 0/4

RECORD

Cased _____ in., _____ ft.

Sand _____

Gas _____

Oil _____

Total Depth 2720

PRODUCTION

1st 24 hrs. Nat. _____

1st 24 hrs. after shot _____

Gas _____ Cu. Ft.

Dry Hole _____

Abandoned _____

Date

SEP 13 1944

19

S. J. LEWIS

Scout