

Map No. K Sec. 24 Twp. 32 R. 4


Well No. 1 Helfelder Farm
Mc Hae et al Company

200 Ft. from N. Line

_____ Ft. from S. Line

_____ Ft. from E. Line

200 Ft. from W. Line

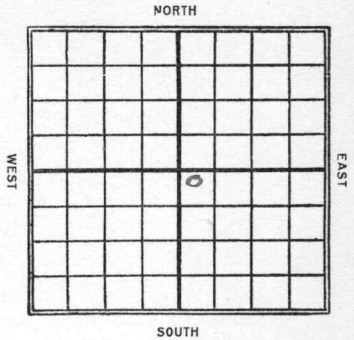

Date
1922

REPORT

1/3 ully up 10" D1440'
2/4 SHL 1550'
3/30 S. D. 1550'
W. & A. @ 1480' on acct
of fishing job.

Map No. 2 Sec. 24 Twp. 32 R. 4

Well No. 1 Rebelder Farm
Mc Nat. et al. Company

Date Started _____ Ft. from N 200 S. E. W 20 line

NORTH Kansas



SOUTH

Cased _____ In. _____ Ft.	Production Remarks
Sand _____	
Pay { Gas _____ Oil _____	

Condition of Well on this date _____
20' log up 10" at 1440'

A. BENDAR

Map No. 2 Kans 24 Sec. 24 Twp. 32 R. 4

Well No. 1 Helfelder

M. C. Nat. et al Company

Contractor

ABANDONED

SECTION PLAT

200' Ft. from N. Line

_____ Ft. from S. Line

_____ Ft. from E. Line

200' Ft. from W. Line

		o	

Location _____

Rig up _____

Drilling and Remarks:

LVA. @ 1480'
on acct of
fishing job

RECORD

Cased _____ in., _____ ft.
Sand _____
Gas _____
Oil _____
Total Depth _____

PRODUCTION

1st 24 hrs. Nat. _____
1st 24 hrs. after shot _____
Gas _____ Cu. Ft.
Dry Hole _____
Abandoned _____

Date

M.A.B. 7/23/24