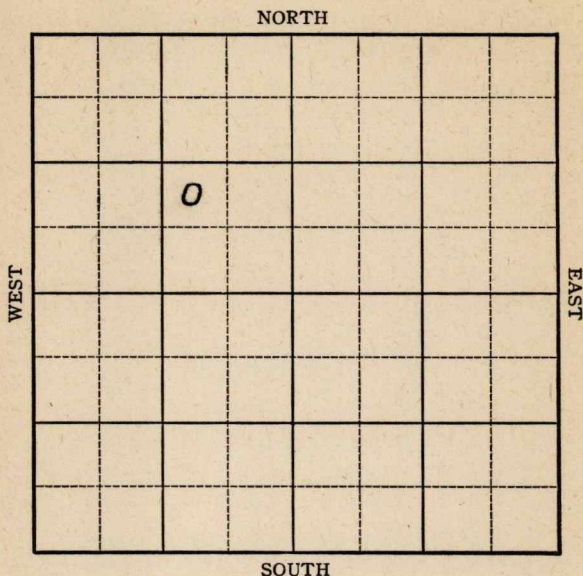


KANSAS

Butler

Section 35 Township 27 Range 5E#4
Well No. ± WeaverCompany Cromwell & Lewis

KANSAS

Butler County

Sec. 35 Twp. 27 R. 5E

Well No. #1 Weaver Farm

Cromwell & Lewis Company


Miscellaneous

 Ft. from N. Line

990 Ft. from S. Line

990 Ft. from E. Line

 Ft. from W. Line

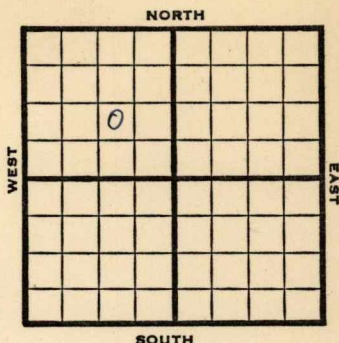

NW SE NW

1946 **Elev 1324'** REPORT

5/1 Machine
5/7 "
5/14 "
5/21 "
5/29 10" @ 1353
Drlg. 1850'
6/5 **Lans 1828**
8" @ 1950
KC 2156
BKC 2370
Drlg. 2420'
6/19 **Viola 3128'**
Arb 3171'
TD 3177'

abd.

ABANDONED

KANSASKansas Pool Name MiscellaneousMap No. 11 Sec. 35 Twp. 27 R. 5EWell No. 4 WeaverCromwell & Lewis

Company

ABANDONED

Contractor

NW SE NW

E 11824
SECTION PLATFt. from N. Line990 Ft. from S. Line990 Ft. from E. LineFt. from W. Line

	0		

Butler County**RECORD**

Location _____

Cased _____ in., _____ ft.

Rig up _____

Sand _____

Drilling and Remarks:

Gas _____

Oil _____

Total Depth 3177**PRODUCTION**

1st 24 hrs. Nat. _____

1st 24 hrs. after shot _____

Gas _____ Cu. Ft.

Dry Hole _____

Abandoned _____

Date

JUN 19 1946

19


S. J. LEWIS

Scout

KANSASKansas Pool Name MiscellaneousMap No. // Sec. 35 Twp. 27 R. 5EWell No. 4 WeaverCromwell & Lewis CompanyCORRECTION Contractor

NW SE NW

SECTION PLAT

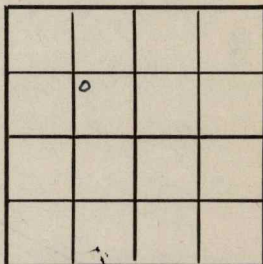 Ft. from N. Line990 Ft. from S. Line990 Ft. from E. Line Ft. from W. LineButler CountyLocation Rig up

Drilling and Remarks:

Reported
#1 Weaver

RECORD

Cased in., ft.Sand Gas Oil Total Depth

PRODUCTION

1st 24 hrs. Nat. 1st 24 hrs. after shot Gas Cu. Ft.Dry Hole Abandoned

Date

JUN 5 1946 19 S. J. LEWIS Scout

KANSASKansas Pool Name MiscellaneousMap No. // Sec. 35 Twp. 27 R. 5EWell No. 1 WeaverCromwell & Lewis Company

FIRST REPORT

Contractor

NW SE NW

SECTION PLAT

	0		

 Ft. from N. Line990 Ft. from S. Line990 Ft. from E. Line Ft. from W. LineButler CountyLocation Rig up

Drilling and Remarks:

Machine

RECORD

Cased in., ft.Sand Gas Oil Total Depth

PRODUCTION

1st 24 hrs. Nat. 1st 24 hrs. after shot Gas Cu. Ft.Dry Hole Abandoned

Date

MAY 1 1946 19S. J. LEWIS Scout