


Map No. _____ Sec. 24 Twp. 32 R. 4

Well No. 2 Kukuk Farm _____
Emerald Oil Company

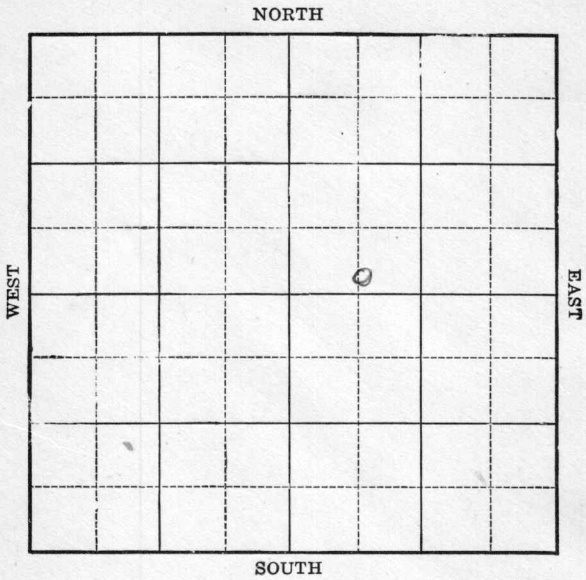

Location _____
Drilling Remarks _____

Rig Up _____
Drilling Remarks _____

RECORD

PRODUCTION

Cased _____ in. _____ ft.
Sand _____
Gas _____
Oil _____
Total Depth _____

1st 24 hrs. Nat. _____
1st. 24 hrs. after shot _____
Gas _____ cu. ft.
Dry Hole _____
Abandoned _____

Map No. *Kans* Sec. *24* Twp. *32* R. *4*


Well No. *2 Kukuk* Farm
Emerald O. & G. Company

..... Ft. from N. Line

220 Ft. from S. Line

..... Ft. from E. Line

640 Ft. from W. Line

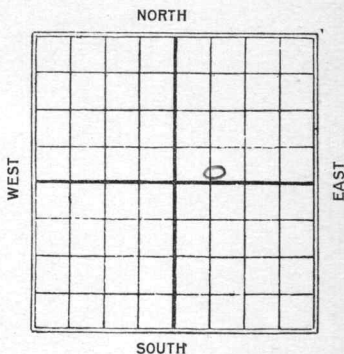

1st + Comp

Date
1925

REPORT

*1/24 Sand 1448-75 T.D. 1475
Est 30 Bbls*

Map No. 2 Sec. 24 Twp. 32 R. 4

Well No. 2 Kukuk

Emerald O & G Company

FIRST REPORT Contractor

COMPLETED

SECTION PLAT

----- Ft. from N. Line

220' Ft. from S. Line

----- Ft. from E. Line

640' Ft. from W. Line

		o	

Location -----

Rig up -----

Drilling and Remarks:

sand. 1448-75
J.D. 1475
est 30 lbs.

RECORD

Cased ----- in., ----- ft.

Sand -----

Gas -----

Oil -----

Total Depth -----

PRODUCTION

1st 24 hrs. Nat. -----

1st 24 hrs. after shot -----

Gas ----- Cu. Ft.

Dry Hole -----

Abandoned -----

Date

1/24 1925

M. A. BENEAR

Scout