

Sec. 35 Twp. 27 R. 5E

Well No. #3 White Farm
Crownwell & Lewis Company

Miscellaneous


_____ Ft. from N. Line

330 Ft. from S. Line

_____ Ft. from E. Line

990 Ft. from W. Line

SE SW NW

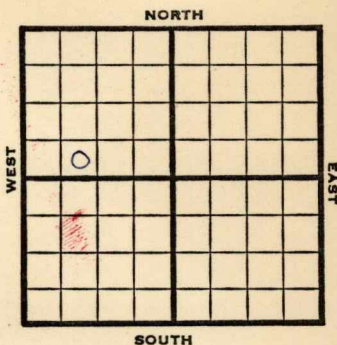

1946 **Elev. 1316'** REPORT

- 3/6 Spud
- 3/14 12" - 350' Drlg. 610'
- 3/21 10" - 1344' Drlg. 1465'
- 3/28 8" - 1905' **K.C. 2144'**
Drlg. 2350'
- 4/4 **Bart. 2684**
7" @ 2690
TD 2930'
- 4/10 " "
- 4/16 5" @ 3111 TD
- 4/23 **Viola 3123**
TD 3125 SO
- 5/1 1000 acid
- 5/7 " "
- 5/15 **Viola 3123**
5" @ 3111
TD 3125
Bart 2684
PB 2690
Pump 30 Pot.
Grav. 38.0

COMPLETED

KANSAS

Kansas Pool Name Miscellaneous

Map No. 4 Sec. 35 Twp. 27 R. 5E

Well No. 3 White

Crownwell & Lewis Company

COMPLETED

Contractor

SE SW NW

E 11816

SECTION PLAT

_____ Ft. from N. Line

330 Ft. from S. Line

_____ Ft. from E. Line

990 Ft. from W. Line

Butler County

Location _____

Rig up _____

Drilling and Remarks:

*Viola 3123
503111
Bar Y2684 PS2690
Pump 30 ft*

38° SW

RECORD

Cased _____ in., _____ ft.

Sand _____

Gas _____

Oil _____

Total Depth 3125

PRODUCTION

1st 24 hrs. Nat. _____

1st 24 hrs. after shot _____

Gas _____ Cu. Ft.

Dry Hole _____

Abandoned _____

Date

MAY 15 1946 19

S. J. LEWIS Scout