


Section 36 Township 27 Range 5E

Well No. #1 Covert

Company Rex & Morris

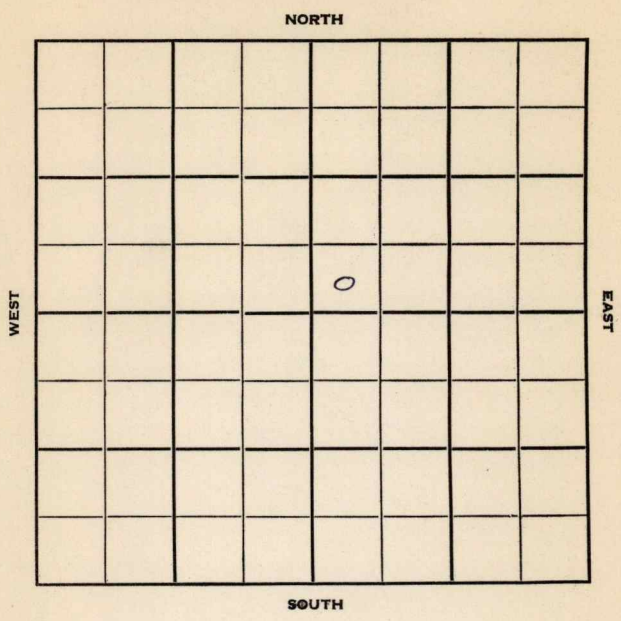

Butler

Sec. 36 Twp. 27 R. 5E

Well No. #1 Covert Farm

Rex & Morris Company

Contractor

Ft. from N. Line

330'


Ft. from S. Line

Ft. from E. Line

330'

Ft. from W. Line

SW SW NE

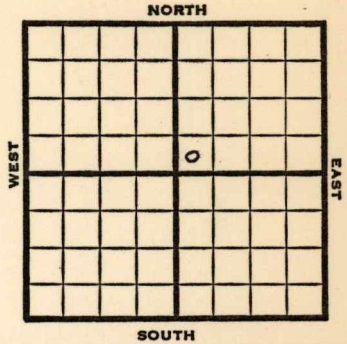

1951

Elev. 1316' REPORT

9/26

Location

10/17

Spud 9-24-51

D&A

TD 2707

8" @ 101

Bart. 2632

Sand 2703-05

5" @ 2703

TD 2705 1 BOPH DD 2707 wtr.

D&A

ABANDONED

