


Map No. Kansas Sec. 24 Twp. 32 R. 4

Well No. 6 Kukup Farm _____
Emerald Company

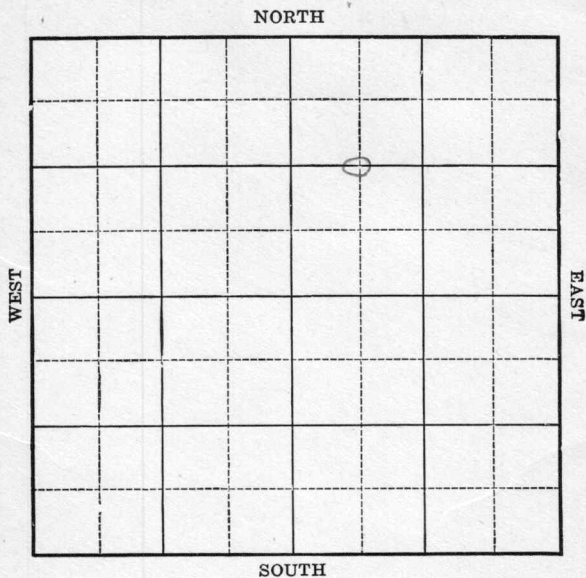

Location _____
Drilling Remarks _____

Rig Up _____
Drilling Remarks _____

RECORD

Cased _____ in. _____ ft.
Sand _____
Gas _____
Oil _____
Total Depth _____

PRODUCTION

1st 24 hrs. Nat. _____
1st. 24 hrs. after shot _____
Gas _____ cu. ft.
Dry Hole _____
Abandoned _____

Map No. Kans Sec. 24 Twp. 32 R. 4


Well No. 6 KKKK Farm _____
Emerald Company

_____ Ft. from N. Line

1320 Ft. from S. Line

_____ Ft. from E. Line

660 Ft. from W. Line

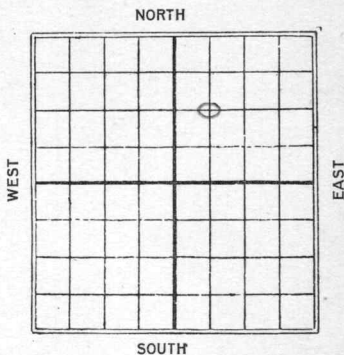

1st & Comp

Date
1925

REPORT

1/24

S. & G. T.D. 1493'

Map No. **KANSAS** Sec. 24 Twp. 32 R. 4

Well No. 6 Kukuk

Emerald Company

FIRST REPORT Contractor

ABANDONED

SECTION PLAT

----- Ft. from N. Line

1320' Ft. from S. Line

----- Ft. from E. Line

660' Ft. from W. Line

Location -----

Rig up -----

Drilling and Remarks:

J.D. 1493

L.O.A.

RECORD

Cased ----- in., ----- ft.

Sand -----

Gas -----

Oil -----

Total Depth -----

PRODUCTION

1st 24 hrs. Nat. -----

1st 24 hrs. after shot -----

Gas ----- Cu. Ft.

Dry Hole -----

Abandoned -----

Date

1/24

1925

M. A. BENEAR

Scout

Cowley

K2 KANSAS MAP NO. _____ SEC. 24 TWP. 32S R. 4E

WELL No. 6 Kukukuk

Emerald COMPANY

CONTRACTOR

SECTION PLAT

ABANDONED

		o	

_____ FT. FROM N. LINE

_____ FT. FROM S. LINE

_____ FT. FROM E. LINE

_____ FT. FROM W. LINE

RECORD

LOCATION _____

RIG UP _____

DRILLING AND REMARKS:

CASED _____ IN., _____ FT.

SAND _____

GAS _____

OIL _____

TOTAL DEPTH 1493

PRODUCTION

1ST 24 HRS. NAT. _____

1ST 24 HRS. AFTER SHOT _____

GAS _____ CU. FT.

DRY HOLE ✓

ABANDONED ✓

DATE

4/30

192 3

SCOUT