


12-11-24^e *Plotted*
Now

WELL LOG BUREAU—KANSAS GEOLOGICAL SOCIETY
412 Union National Bk. Bldg., Wichita, Kansas

Company - W. VOGEL
Farm - ? No. 1

SEC. 12 T. 11 R. 24 E
NWc NW

Total Depth. 435'
Comm. 5-6-45 Comp. 5-14-45
Shot or Treated.
Contractor. Cullum & Brown
Issued. 6-2-45

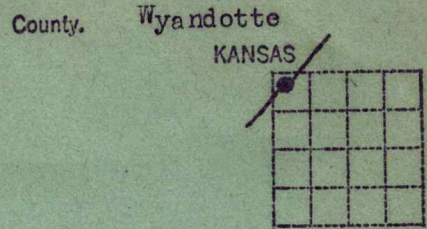

CASING:

Elevation. _____

Production. Dry

Figures Indicate Bottom of Formations.

boulders & clay	9
lime	20
shale blue wtr	25
shale lgt	45
lime gy	56
shale gy	60
shale green	67
lime gy	77
shale drk	82
lime	101
shale drk	110
lime	112
shale drk	114
lime	116
shale green	120
lime	132
shale green	135
lime gy	152
shale drk	156
lime (Bethany Falls)	176
shale	180
lime	182
shale drk	185
lime	193
shale wh	207
sand brkn	214
gas bubbles	
shale gy	230
shale gy sdy some wtr	270
shale gy	310
shale & sand	315
shale wh	330
sand brkn	340
shale lgt	350
shale lgt blue	364
lime gy	370
shale drk	372
lime	375
shale gy	390
shale wh	396
lime	400
sand brkn	404
sand	414
shale gy	426
lime	433
slate	435
Total Depth.	