


Kansas

Map No. _____ Sec. 36 Twp. 27 R. 5Well No. 1 Gates FarmGardner & Smith Company

NORTH

WEST

EAST

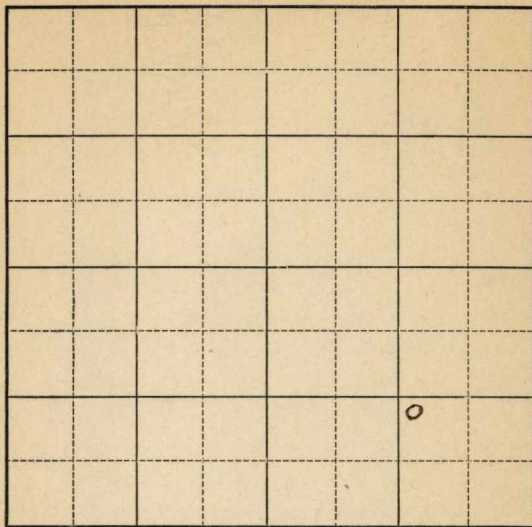

SOUTH

Location _____

Drilling Remarks:

RECORD

Cased _____ in. _____ ft.

Sand _____

Gas _____

Oil _____

Total Depth _____

Rig Up _____

Drilling Remarks:

PRODUCTION

1st 24 hrs. Nat. _____

1st 24 hrs. after shot _____

Gas _____ cu. ft.

Dry Hole _____

Abandoned _____

Map No. _____ Sec. 36 Twp. 27 R. 5

Well No. #1 Yates Farm
Garden & Smith Company


NORTH

_____ Ft. from N, Line

1120 Ft. from S. Line

1120 Ft. from E. Line

Ft. from W. Line

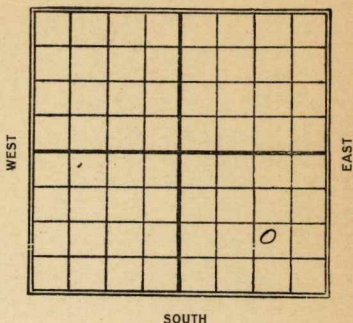

SOUTH

Date _____

REPORT

Dlg 700
 Avd 2825

Map No. Gas 11 Sec. 36 Twp. 27 R. 5Well No. 1 Yates
Gardner & Smith Company

Contractor

FIRST REPORT

Ft. from N. Line

1120 Ft. from S. Line1120 Ft. from E. Line

Ft. from W. Line

SECTION PLAT

			0

Location

Rig up

Drilling and Remarks:

10, 700'

RECORD

Cased _____ in., _____ ft.

Sand _____

Gas _____

Oil _____

Total Depth _____

PRODUCTION

1st 24 hrs. Nat. _____

1st 24 hrs. after shot _____

Gas _____ Cu. Ft.

Dry Hole _____

Abandoned _____

Date

JUL 15 1922

M. A. BENEAR

191

Scout

Map No. Kaus 11 Sec. 36 Twp. 27 R. 5Well No. 1 2 fatts
Garden & Smith Company

Contractor

ABANDONED**SECTION PLAT**

Ft. from N. Line

1120'

Ft. from S. Line

1120'

Ft. from E. Line

Ft. from W. Line

			0

Location

Rig up

Drilling and Remarks:

RECORD

Cased _____ in., _____ ft

Sand _____

Gas _____

Oil _____

Total Depth _____

PRODUCTION

1st 24 hrs. Nat. _____

1st 24 hrs. after shot _____

Gas _____ Cu. Ft

Dry Hole ☒Abandoned 2725

Date

JUL - 22 - 1922

191

M. A. BENEAR

Scou