


Section 1 Township 27 Range 6-E

Well No. #1 Bolin

Company Ralph Wixson et al

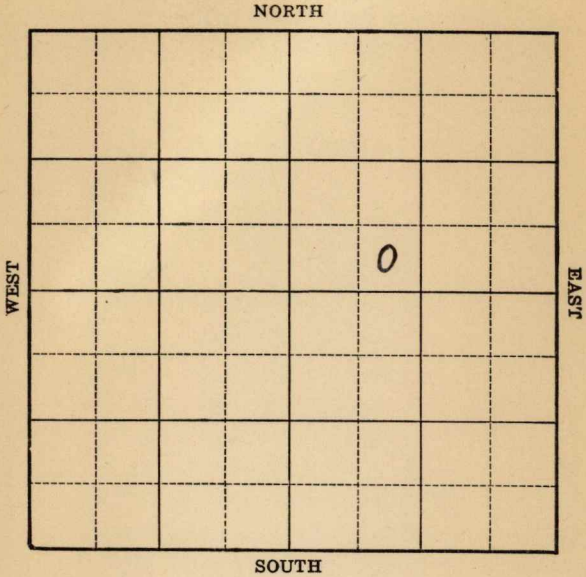

Sec. 1 Twp. 27 R. 6-E

Well No. #1 Bolin Farm
Ralph Wixson et al Company


(Leon)

_____ Ft. from N. Line

330 Ft. from S. Line

_____ Ft. from E. Line

990 Ft. from W. Line

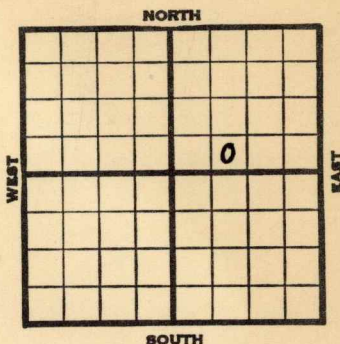

Elev. 1374

1939	REPORT
12/6	Location
12/14	"
12/21	"
12/28	"
1940	
1/4	"
1/11	"
1/18	"
1/25	"
2/1	"
2/8	"
2/15	"
2/23	"
2/29	"
3/8	"
3/14	Material.
3/21	"
3/28	"
4/4	"
4/12	"
4/18	"
4/26	Drlg. 155' OVER

1940

5/2 SD 500'

5/9 15" - 239' 13" - 1078'
Drlg. 1435'

5/16 HFW 1470-80' 10" - 1528'
Lansing 1700' Drlg. 1820'

5/23 K.C. 2014' Drlg. 2500'

5/29 8" - 2143' 6" - 2798'
Miss. 2768' Drlg. 2838'

6/5 Miss. 2678'
B. Miss. 3030'
T.D. 3105'
H.F.W.

ABANDONED

Map No. // Sec. 1 Twp. 27 R. 6E

Well No. 1 Bolin

Ralph Wixson et al

Company

Contractor

FIRST REPORT

SE SW NE

Ft. from N. Line

330 Ft. from S. Line

Ft. from E. Line

990 Ft. from W. Line

SECTION PLAT

LEON POOL

Location X

Rig up

Drilling and Remarks:

RECORD

Cased in., ft.

Sand

Gas

Oil

Total Depth

PRODUCTION

1st 24 hrs. Nat.

1st 24 hrs. after shot

Gas Cu. Ft.

Dry Hole

Abandoned

Date

DEC 6 1939

19

S. J. LEWIS

Scout

Map No. 11 Sec. 1 Twp. 27 R. 6E

Well No. 1 Bolin

Ralph Wixon etal Company

Contractor

ABANDONED

SE SW NE

SECTION PLAT

		0	

 Ft. from N. Line

330 Ft. from S. Line

 Ft. from E. Line

990 Ft. from W. Line

LEON POOL

Location

Rig up

Drilling and Remarks:

Miss 2678
B Miss 3030
HFW.

RECORD

Cased in., ft.

Sand

Gas

Oil

Total Depth 3105.

PRODUCTION

1st 24 hrs. Nat.

1st 24 hrs. after shot

Gas Cu. Ft.

Dry Hole

Abandoned

Date

JUN 5 1940 19

S. J. LEWIS Scout