


Map No. _____ Sec. 36 Twp. 27 R. 5Well No. 2600000 Farm _____
Braden & Co Company _____

NORTH

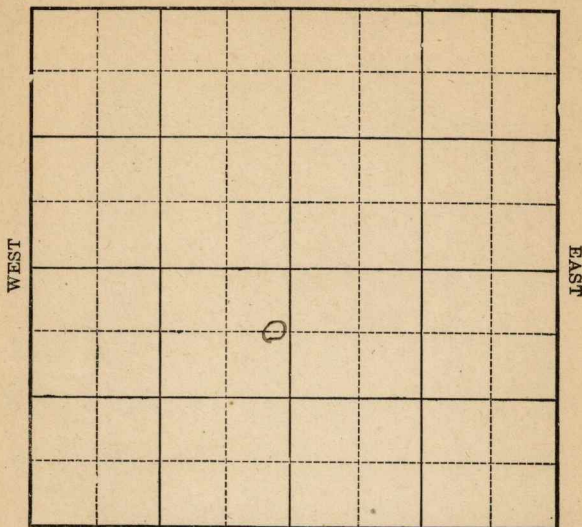

SOUTH

Location _____

Drilling Remarks:

Rig Up _____

Drilling Remarks:

RECORD

Cased _____ in. _____ ft.

Sand _____

Gas _____

Oil _____

Total Depth _____

PRODUCTION

1st 24 hrs. Nat. _____

1st 24 hrs. after shot _____

Gas _____ cu. ft.

Dry Hole _____

Abandoned _____

Map No. _____ Sec. 36 Twp. 27 R. 5


Well No. 2 Corent Farm _____
Bradew & Cole Company _____

660 Ft. from N. Line

_____ Ft. from S. Line

200 Ft. from E. Line

_____ Ft. from W. Line

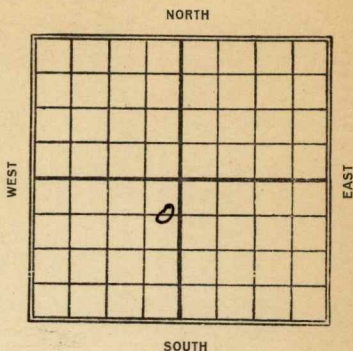

Date
1923

REPORT

1/26 Spud.
3/22 Sand 2765-85-A shot
200fts. 50 Bbls.

Map No. **KANSAS** 11 Sec. **36** Twp. **27** R. **5**Well No. **2 Cover****Braden & Co** Company

Contractor

FIRST REPORT

660 Ft. from N. Line

Ft. from S. Line

200 Ft. from E. Line

Ft. from W. Line

SECTION PLAT

Location

Rig up

Drilling and Remarks:

spud.

RECORD

Cased _____ in., _____ ft.

Sand _____

Gas _____

Oil _____

Total Depth _____

PRODUCTION

1st 24 hrs. Nat. _____

1st 24 hrs. after shot _____

Gas _____ Cu. Ft.

Dry Hole _____

Abandoned _____

Date **JAN 26 1923****M. A. BENEAR** Scout

Map No. **KANSAS** 11 Sec. **36** Twp. **27** R. **5**Well No. **2 Covert**
Bradley & Co. Company

Contractor

COMPLETED

SECTION PLAT

660' Ft. from N. Line

Ft. from S. Line

200' Ft. from E. Line

Ft. from W. Line

	o		

Location

Rig up

Drilling and Remarks:

*sand {2765
2785}**shot 20 gals
50 lbs.*

RECORD

Cased _____ in., _____ ft.

Sand _____

Gas _____

Oil _____

Total Depth _____

PRODUCTION

1st 24 hrs. Nat. _____

1st 24 hrs. after shot _____

Gas _____ Cu. Ft.

Dry Hole _____

Abandoned _____

Date

M. A. BENEAR**MAR 22 1923**

192

Scout