


Butler

FORM 252A-5M-12-28-PETROL

Map No. **KANSAS** Sec. 36 Twp. 27 R. 5^E

Well No. 1- Laydon Farm
Phillips Pet Company

_____ Ft. from N. Line
660 Ft. from S. Line
660 Ft. from E. Line
_____ Ft. from W. Line

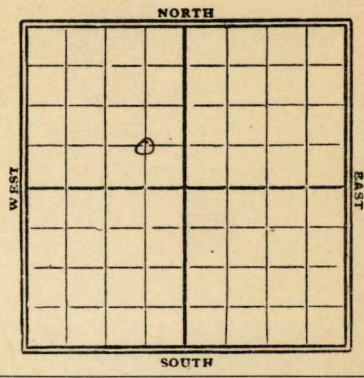

1929

Date	REPORT
5/22	Location
5/29	Top
6/15	2dy 275'
6/12	Wrlly 1018'
6/19	" 1900'
6/26	Top line 2715'
7/2	Wrlly 2740'
7/2	2dy shale 2690-2715
	Top line 2715-3027
	" Viola 3109-27
	T.D. 3127'-HFW
	Abandon

Map No. *Butler* Sec. *36* Twp. *27* R. *5* ^E

Well No. *Randon*
Phillips Fuel Co Company

Contractor

FIRST REPORTS

SECTION PLAT

..... Ft. from N. Line
660 Ft. from S. Line
660 Ft. from E. Line
..... Ft. from W. Line

	o		

Location

Rig up

Drilling and Remarks:

RECORD

Cased.....in.,ft.
Sand.....
Gas.....
Oil.....
Total Depth.....

PRODUCTION

1st 24 hrs. Nat.....
1st 24 hrs. after shot.....
Gas.....Cu. Ft.
Dry Hole.....
Abandoned.....

Date

MAY 22 1929

CHAS. L. SHERWOOD

.....192..... Scout

Butler

Map No. **KANSAS** Sec. 36 Twp. 27 R. 5

Well No. 1 Randon

Phillips pet co Company
Contractor

COMPLETE

SECTION PLAT

_____ Ft. from N. Line

660 Ft. from S. Line

660 Ft. from E. Line

_____ Ft. from W. Line

	0		

ABANDONED

Location _____

Rig up _____

Drilling and Remarks:

Sdy Shar 2690-2715
top L 2715-3027
top Viola 3109-27
AFW

RECORD

Cased _____ in., _____ ft.

Sand _____

Gas _____

Oil _____

Total Depth 3027

PRODUCTION

1st 24 hrs. Nat. _____

1st 24 hrs. after shot _____

Gas _____ Cu. Ft.

Dry Hole

Abandoned

Date

7/2 1929

CHAS. L. SHERWOOD

Scout