


Map No. _____ Sec. 36 Twp. 27 R. 5
 Well No. 2 Gates Farm _____
Gates Oil Company _____
W. R. W. Col. Eval
 NORTH

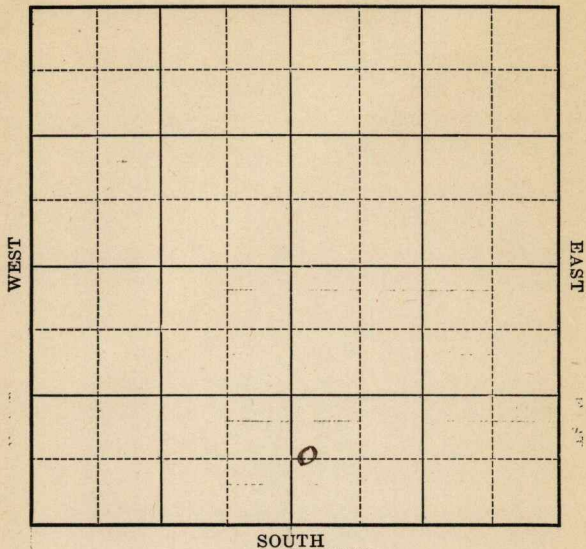

Location _____

Drilling Remarks:

Rig Up _____

Drilling Remarks:

RECORD

Cased _____ in. _____ ft.

Sand _____

Gas _____

Oil _____

Total Depth _____

PRODUCTION

1st 24 hrs. Nat. _____

1st 24 hrs. after shot _____

Gas _____ cu. ft.

Dry Hole _____


Abandoned _____

Map No. _____ Sec. 36 Twp. 27 R. 5Well No. # 2 Yates Farm _____Yates Oil Company _____
was R. H. Cole et al

_____ Ft. from N. Line

660 Ft. from S. Line

_____ Ft. from E. Line

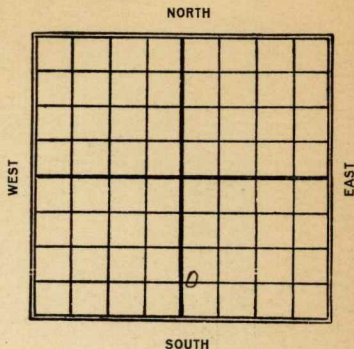200 Ft. from W. Line

Date

REPORT

19225/6Rip7/52651-59 TD 2659Shot 40 gts 250 B bls

Map No. K11 Sec. 36 Twp. 27 R. 5Well No. 2 YatesCompany Yates OilContractor Wm R.W. Cole et al Co.

SECTION PLAT

Ft. from N. Line

660 Ft. from S. Line

Ft. from E. Line

200 Ft. from W. Line

FIRST REPORT			

Location -----

Rig up -----

Drilling and Remarks:

Rig

RECORD

Cased ----- in., ----- ft.

Sand -----

Gas -----

Oil -----

Total Depth -----

PRODUCTION

1st 24 hrs. Nat. -----

1st 24 hrs. after shot -----

Gas ----- Cu. Ft.

Dry Hole -----

Abandoned -----

Date

MAY 6 1922M. A. BENEAR,191

Scout

Map No. Gas 11 36 Sec. 27 Twp. 5 R. 5Well No. 2 YatesYates oil Company

Contractor

COMPLETED SECTION PLAT

Ft. from N. Line

660 Ft. from S. Line

Ft. from E. Line

200 Ft. from W. Line

		0	

Location

Rig up

Drilling and Remarks:

shot 40 ft**RECORD**

Cased in., ft.

Sand

Gas

Oil 2651-59Total Depth 2659**PRODUCTION**

1st 24 hrs. Nat.

1st 24 hrs. after shot 250

Gas Cu. Ft.

Dry Hole

Abandoned

Date

JUL 15 1912

191

M. A. BENEAR Scout